

**SURVEY &  
REMONUMENTATION**

APR 24 1995

OTTAWA COUNTY REMONUMENTATION  
LAND CORNER RECORDATION CERTIFICATE  
Filing Requirement of Act 74, Mich. P.A. 1970

RECORDED

94 DEC 15 AM 11:52

COMMISSION

For corners in

*Elizabeth R. Kellman*  
REGISTER OF DEEDS  
OTTAWA COUNTY, MI

Ottawa (County) Located In: Crockery Twp. Corner Code #  
1. Public Land Survey T 8N R 15W C-9  
T \_\_\_\_\_ R \_\_\_\_\_ SW Corner  
T \_\_\_\_\_ R \_\_\_\_\_ Section 20  
T \_\_\_\_\_ R \_\_\_\_\_  
2. Property Controlling S \_\_\_\_\_ T \_\_\_\_\_ R \_\_\_\_\_  
in Section S \_\_\_\_\_ T \_\_\_\_\_ R \_\_\_\_\_  
3. Miscellaneous S \_\_\_\_\_ T \_\_\_\_\_ R \_\_\_\_\_  
Property in Sec. S \_\_\_\_\_ T \_\_\_\_\_ R \_\_\_\_\_

Register of Deeds Stamp & File Number

4. Lot No. \_\_\_\_\_, Recorded Plat \_\_\_\_\_  
5. Private Claims \_\_\_\_\_

	A	B	C	D	E	F	G	H	I	J	K	L	M
2	6		5		4		3		2		1		
3													
4	7		8		9		10		11		12		
5													
6	16		17		16		15		14		13		
7													
8	19		20		21		22		23		24		
9													
10	30		29		28		27		26		25		
11													
12	31		32		33		34		35		36		
13													

I, Carl P. Englert, in a field survey on December 05, 19 94, do hereby certify that under requirements of P.A. 74, Michigan P.A. of 1970, the corner points mentioned in lines 1 and 2 above were in conformance with regulations and rules therefore as required in the current manual of survey instructions of the United States Department of the Interior, Bureau of Land Management or by a decree of a Court of Law and/or that the corner points mentioned in lines 3, 4 and 5 above were in conformance with the rules of the Michigan Board of Land Surveyors or by a Decree of a Court of Law; established, re-established, monumented, re-monumented, recovered, found as expressed below:

NOTE: Not more than 4 corners, all in the same town and range, may be recorded on this certificate.

A. Description of original monument and accessories and/or subsequent restoration:  
C-9 corner common to Sections 19, 20, 29 & 30  
Original Gov't corner set March, 1832 by John Mullet, D.S. LCRC Liber 5, Page 106 (7/25/94)  
C-9 Cast Iron Monument  
18" Oak NNE 57.08'  
30" White Pine ENE 110.20'  
9" Oak ESE 18.68'  
27" Ash SSE 39.00'  
2" I.D. Pipe S 16.33'


(See Back of Page)  
B. Description of corner evidence found and/or method applied in restoring or reestablishing corner:  
C-9 corner common to Sections 19, 20, 29 & 30  
Found 4" Harrison CIM 3" deep  
Found 20" Oak NNE 57.08'  
Found 30" W. Pine ENE 110'+/- (No Nail)  
Found 9" Oak ESE 18.68'  
Found 27" Ash SSE 39.00'  
Found 2" I.D. Pipe S. 16.33'

PA. 345 OTTAWA COUNTY  
PEER APPROVED 12/12/94  
*Richard D. Pedersen*

Accepted as a careful and faithful perpetuation of the original position of the corner.

C. Description of monument for corner and accessories established to perpetuate locating the position of the corner:  
C-9 corner common to Sections 19, 20, 29 & 30  
4" Harrison Cast Iron Mon.  
O.C. Remon. Tag & Nail in W. side 20" Oak N 5°E 57.17'  
O.C. Remon. Tag & Nail in S. side 15" Oak S85°E 18.44'  
O.C. Remon. Tag & Nail in N.E. side 28" Ash S10°E 38.29'  
O.C. Remon. Tag & Nail in S. side 8" Oak N50°E 54.64'  
2" I.D. Iron Pipe South 16.33'

Signed by Carl P. Englert Jr. Date 12/5/94  
Surveyor's Michigan License No. 18987

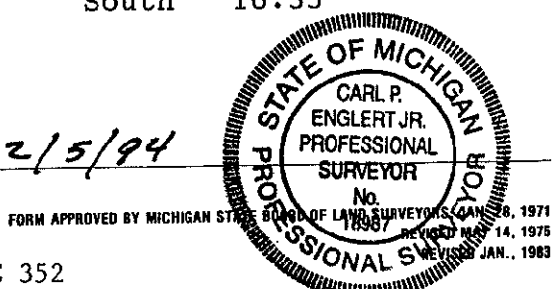

LCRC Liber 3, Page 225 (11/14/77)

C-9 Found 3/4" Iron Pipe

N-S Fence Line	S	
Faint Fence Line	E	
24" White Pine	N80°E	110.34'
3" Iron	S	16.47'
16" Butternut	S	38.21'
18" Butternut	S	3.93'

LCRC Liber 1, Page 519

C-9) Replaced Iron pipes with Cast Iron Monument  
Inscribed "Ottawa County Section Corner."

Ties:

N&S Fence Line	S	
24" White Pine	N80°E	110.34'
3" Iron	S	16.47'
16" Butternut	S	38.21'

120 #  
 150 #  
