

**SURVEY & REMONUMENTATION**

DEC 01 1998

**OTTAWA COUNTY REMONUMENTATION  
LAND CORNER RECORDATION CERTIFICATE  
Filing Requirement of Act 74, Mich. P.A. 1970**

**SECTION**

For corners in

<u>Ottawa</u> <small>(County)</small>	Located In:	Corner Code #
1. Public Land Survey	T 8 N R 15 W	C-11
	T _____ R _____	_____
	T _____ R _____	_____
	T _____ R _____	_____
2. Property Controlling in Section	S _____ T _____ R _____	NW corner
	S _____ T _____ R _____	Section 32
	S _____ T _____ R _____	Crockery Twp
3. Miscellaneous Property in Sec.	S _____ T _____ R _____	_____
	S _____ T _____ R _____	_____

**RECORDED**  
98 JUL 24 PM 1:45

*Ray Schell*  
REGISTER OF DEEDS  
OTTAWA COUNTY, MI

Register of Deeds Stamp & File Number

4. Lot No. \_\_\_\_\_, Recorded Plat \_\_\_\_\_  
5. Private Claims \_\_\_\_\_

I, Steve Lampen, in a field survey on May 19 98, do hereby certify that under requirements of P.A. 74, Michigan P.A. of 1970, the corner points mentioned in lines 1 and 2 above were in conformance with regulations and rules therefore as required in the current manual of survey instructions of the United States Department of the Interior, Bureau of Land Management or by a decree of a Court of Law and/or that the corner points mentioned in lines 3, 4 and 5 above were in conformance with the rules of the Michigan Board of Land Surveyors or by a Decree of a Court of Law; established, re-established, monumented, re-monumented, recovered, found as expressed below:

	A	B	C	D	E	F	G	H	I	J	K	L	M
1													
2	6	5	4	3	2	1							
3													
4	7	8	9	10	11	12							
5													
6	18	17	16	15	14	13							
7													
8	19	20	21	22	23	24							
9													
10	30	29	28	27	26	25							
11													
12	31	32	33	34	35	36							
13													

**NOTE: Not more than 4 corners, all in the same town and range, may be recorded on this certificate.**

A. Description of original monument and accessories and/or subsequent restoration:

C-11  
GLO-Mullett - 1837  
North between Sections 31  
and 32 55.88 old post on  
left bank of Grand River

C-11 is shown on survey in:  
L1 surveys P 957-Roon-1973  
L1 surveys P 352-Clapp-1972  
L2 surveys P 460-Clapp-1974

80.00 set post corner  
Sec. 29,30,31 and 32 in Bayou

PA. 345 OTTAWA COUNTY  
PEER APPROVED 6-15-98  
*J.D.N.*

B. Description of corner evidence found and/or method applied in restoring or reestablishing corner:

C-11 Surveys listed in Part A and other unrecorded surveys are referenced to a Section 30 survey by David Greer in 1968. In this survey Mr. Greer located C-9 and the NE corner of the SE 1/4 of the SE 1/4 Section 30 and extends the section line South 1/3 of the distance from C-9 to the NE corner SE 1/4 of the SE 1/4 to calculate the position of C-11. The NE corner of the SE 1/4 SE 1/4 Section 30 was monumented by Emmet Peck in 1910 and one witness - Maple 16 South 62.1/2 64.4 - remains.

Re-established the position of C-11 by using the same procedure as Dave Greer.

Set an Ottawa County Remonumentation iron and cap at C-11 and is accepted as a careful and faithful re-establishment of the position of the original corner.


See sketch on back

C. Description of monument for corner and accessories established to perpetuate locating the position of the corner:

C-11 Ottawa County Remonumentation iron and cap

Azimuth = Michigan State Plane Grid Direction

Remonumentation tag in East side	8" Ash	356° 47'	256.14
Remonumentation tag in West side	12" Ash	14° 10'	265.64
Remonumentation tag in East side	8" Ash	346° 28'	289.03
Remonumentation tag in East side	10" Ash	352° 33'	262.11

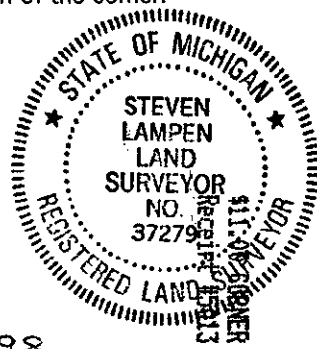

Signed by Steven Lampen  
Surveyor's Michigan License No. 37279

Date July 20, 1998

FORM APPROVED BY MICHIGAN STATE BOARD OF LAND SURVEYORS, JAN. 28, 1971

REVISED MAY 14, 1975  
REVISED JAN., 1983  
ADAPTED FOR WORD PROCESSING MARCH, 1993

SURVEY &  
REMONUMENTATION

DEC 01 1998

SECTION



SECTION.  
30

SECTION  
29

