

SURVEY & REMONUMENTATION

DEC 01 1998

SECTION

**OTTAWA COUNTY REMONUMENTATION
LAND CORNER RECORDATION CERTIFICATE**
Filing Requirement of Act 74, Mich. P.A. 1970

For corners in

Ottawa (County)	Located In:	Corner Code #
1. Public Land Survey	T 8 N R 15 W	C-12
	T R	
	T R	
	T R	West 1/4 corner
2. Property Controlling in Section	S T R	Section 32
	S T R	Crockery Twp
3. Miscellaneous Property in Sec.	S T R	
	S T R	

RECORDED
98 JUL 24 PM 1:45

Ray Hablitz
REGISTER OF DEEDS
OTTAWA COUNTY, MI

Register of Deeds Stamp & File Number

4. Lot No. _____, Recorded Plat _____
5. Private Claims _____

and/or that the corner points mentioned in lines 3, 4 and 5 above were in conformance with the rules of the Michigan Board of Land Surveyors or by a Decree of a Court of Law; established, re-established, monumented, re-monumented, recovered, found as expressed below:

NOTE: Not more than 4 corners, all in the same town and range, may be recorded on this certificate.

	A	B	C	D	E	F	G	H	I	J	K	L	M
1													
2	6	5	4	3	2								
3													
4	7	8	9	10	11	12							
5													
6	18	17	16	15	14	13							
7													
8	19	20	21	22	23	24							
9													
10	30	29	28	27	26	25							
11													
12	31	32	33	34	35	36							
13													

A. Description of original monument and accessories and/or subsequent restoration:

C-12 Peck - stake
GLO - Britain - May 15, 1832 County surveyor records -
North between Sections 31 and 32 Iron and post - 1933
40.00 set 1/2 mile post C-12 to C-13 = 2666'
Oak 20 S 7 E 200
DO 30 N 22 E 73

RA. 845 OTTAWA COUNTY
PEER APPROVED 6-15-98
S.D.N.


B. Description of corner evidence found and/or method applied in restoring or reestablishing corner:

C-12 Found iron pipe and old wood corner fence post
C-12 to C-13 measure 2671 feet
C-12 is 3.8 feet. West of C-11 to C-13
Set Ottawa County remonumentation iron and cap over found iron pipe and is accepted as a careful and faithful perpetuation of the position of the original corner.

C. Description of monument for corner and accessories established to perpetuate locating the position of the corner:

C-12 Ottawa County remonumentation iron and cap

Remonumentation tag in South face	9" Ash	62°	48.81
Remonumentation tag in North face	29" Maple	105°	74.31
Remonumentation tag in South face	21" Maple	128°	67.49
Remonumentation tag in South face	23" Maple	81°	84.03
Remonumentation tag in West face	10" Ash	176°	37.53

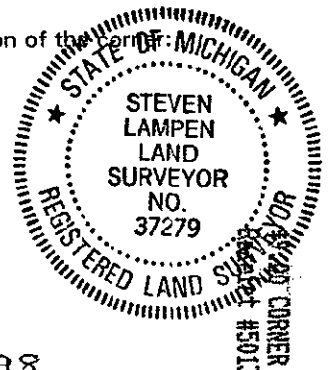

Signed by Steven Lampen
Surveyor's Michigan License No. 37279

Date July 20, 1998

FORM APPROVED BY MICHIGAN STATE BOARD OF LAND SURVEYORS, JAN. 28, 1971
REVISED MAY 14, 1975
REVISED JAN., 1983
ADAPTED FOR WORD PROCESSING MARCH, 1993