

DEC 01 1998

SECTION

OTTAWA COUNTY REMONUMENTATION  
LAND CORNER RECORDATION CERTIFICATE  
Filing Requirement of Act 74, Mich. P.A. 1970

For corners in

<u>Ottawa</u> (Country)	Located In:	Corner Code #
1. Public Land Survey	T 8 N R 15 W T R T 7 N R 15 W T R	C-13 C-1 SW corner Section 32 Robinson Twp
2. Property Controlling in Section	S T R S T R	
3. Miscellaneous Property in Sec.	S T R S T R	

RECORDED  
98 JUL 24 PM 1:44

*Harry [Signature]*  
REGISTER OF DEEDS  
OTTAWA COUNTY, MI

Register of Deeds Stamp & File Number

4. Lot No. \_\_\_\_\_, Recorded Plat \_\_\_\_\_  
5. Private Claims \_\_\_\_\_

1	A	B	C	D	E	F	G	H	I	J	K	L	M
2	6	5	4	3	2	1							
3													
4	7	8	9	10	11	12							
5													
6	18	17	16	15	14	13							
7													
8	19	20	21	22	23	24							
9													
10	30	29	28	27	26	25							
11													
12	31	32	33	34	35	36							
13													

I, Steve Lampen, in a field survey on May 19 98, do hereby certify that under requirements of P.A. 74, Michigan P.A. of 1970, the corner points mentioned in lines 1 and 2 above were in conformance with regulations and rules therefore as required in the current manual of survey instructions of the United States Department of the Interior, Bureau of Land Management or by a decree of a Court of Law and/or that the corner points mentioned in lines 3, 4 and 5 above were in conformance with the rules of the Michigan Board of Land Surveyors or by a Decree of a Court of Law; established, re-established, monumented, re-monumented, recovered, found as expressed below:

NOTE: Not more than 4 corners, all in the same town and range, may be recorded on this certificate.

A. Description of original monument and accessories and/or subsequent restoration:

C-13  
GLO - Britain - 1832 This corner has historically been held as  
West on South side of Section 32 common with C-1 T7NR15W  
  
80.00 set corner to Sections C-13 - Peck  
31 and 32 Pine 24 S 80 1/2 E 70  
Pine 36 N 7 W 68 Oak 16 N 69 1/2 E 80  
DO 40 N 77 E 65  
  
C-1 T7NR15W - Peck  
Pine 24 S 80 1/2 E 70 SW Cor Sc. Ho. N11W 70.2


RA. 345 OTTAWA COUNTY  
PEER APPROVED 6-15-98  
*[Signature]*

B. Description of corner evidence found and/or method applied in restoring or reestablishing corner:

C-13  
Found cast iron monument in a monument box. SW corner Sc. Ho. N11W 70.2  
  
This monument is recorded as C-1 T7NR15W in LCRC L5 P 373  
  
Historically this corner has been held as common with C-1 T7NR15W by Peck and others.  
  
GLO = 26 link jog  
  
C-13 T8NR15W is common with C-1 T7NR15W  
  
Found cast iron monument is accepted as a careful and faithful perpetuation of the position of the original corner

C. Description of monument for corner and accessories established to perpetuate locating the position of the corner:

C-13 Cast Iron Monument in Monument Box  
C-13 T8NR15W is common with C-1 T7NR15W  
  
Azimuth = Michigan State Plane Grid Direction  
  
Remonumentation tag in North side Power pole 110° 29' 91.51  
SE corner old school foundation 9° 27' 71.69  
SW corner old school foundation 349° 24' 70.28  
NE corner house, brick 227° 11' 100.73  
SW corner house, foundation 58° 08' 167.36  
NW corner house, brick 238° 05' 131.93

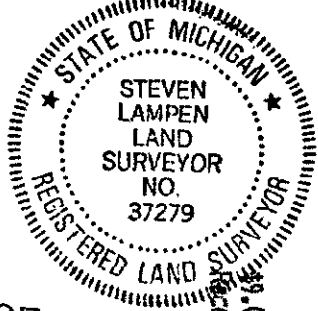

Signed by Steven Lampen Date JULY 20, 1998  
Surveyor's Michigan License No. 37279

FORM APPROVED BY MICHIGAN STATE BOARD OF LAND SURVEYORS JAN. 28, 1971  
REVISED MAY 14, 1975  
REVISED JAN. 1983  
ADAPTED FOR WORD PROCESSING MARCH, 1993