

**SURVEY & REMONUMENTATION**

APR 24 1995

**COMMISSION**

For corners in

OTTAWA COUNTY REMONUMENTATION  
**LAND CORNER RECORDATION CERTIFICATE**  
 Filing Requirement of Act 74, Mich. P.A. 1970

RECORDED

94 DEC 15 AM 11:51

*Richard Carlsson*  
 REGISTER OF DEEDS  
 OTTAWA COUNTY, MI

<u>Ottawa</u> (County)	Located In: Crockery Twp.	Corner Code #
1. Public Land Survey	T <u>8N</u> R <u>15W</u>	D-5
	T _____ R _____	S 1/4 corner
	T _____ R _____	Section 8
	T _____ R _____	_____
2. Property Controlling in Section	S _____ T _____ R _____	_____
	S _____ T _____ R _____	_____
3. Miscellaneous Property in Sec.	S _____ T _____ R _____	_____
	S _____ T _____ R _____	_____
4. Lot No. _____, Recorded Plat _____		
5. Private Claims _____		

Register of Deeds Stamp & File Number

A	B	C	D	E	F	G	H	I	J	K	L	M
2	6	5	4	3	2	1						
3												
4	7	8	9	10	11	12						
5												
6	18	17	16	15	14	13						
7												
8	19	20	21	22	23	24						
9												
10	30	29	28	27	26	25						
11												
12	31	32	33	34	35	36						
13												

I, Carl P. Englert, in a field survey on November 30, 19 94, do hereby certify that under requirements of P.A. 74, Michigan P.A. of 1970, the corner points mentioned in lines 1 and 2 above were in conformance with regulations and rules therefore as required in the current manual of survey instructions of the United States Department of the Interior, Bureau of Land Management or by a decree of a Court of Law and/or that the corner points mentioned in lines 3, 4 and 5 above were in conformance with the rules of the Michigan Board of Land Surveyors or by a Decree of a Court of Law; established, re-established, monumented, re-monumented, recovered, found as expressed below:

**NOTE: Not more than 4 corners, all in the same town and range, may be recorded on this certificate.**

A. Description of original monument and accessories and/or subsequent restoration:

D-5 1/4 corner common to Sections 8 & 17  
 Original gov't corner set March 1837  
 by John Mullet, D.S.

LCRC Liber 6, Page 29 (12/26/89)  
 D-5  
 Set CIM  
 PP SW 56.82  
 Centerline Hyd. NW 58.30  
 40" Oak ENE 76.48  
 PP SE 95.21

(See Back of Page)

B. Description of corner evidence found and/or method applied in restoring or reestablishing corner:

D-5 1/4 corner common to Sections 8 & 17

Found 4" Harrison Cast Iron Monument in Mon. Box 1'+/- N. of Road E  
 Found Hydrant NW 58.30'  
 Found 36" Oak NE 76.48'  
 Found P.P. SE 95.21'  
 Found P.P. SW 56.82'

P.A. 345 OTTAWA COUNTY  
 PEER APPROVED 12/12/94  
*Richard D. Hedrick*

Accepted as a careful and faithful perpetuation of the original position of the corner


C. Description of monument for corner and accessories established to perpetuate locating the position of the corner:

D-5 1/4 corner common to Sections 8 & 17

4" Harrison Cast Iron Monument in Mon. Box  
 O.C. Remon. Tag & Nail in N. side P.P. S63°E 95.12'  
 O.C. Remon. Tag & Nail in S. side 36" Oak N64°E 76.57'  
 O.C. Remon. Tag & Nail in E. side 10" Maple N 7°W 38.10'  
 O.C. Remon. Tag & Nail in S. side 40" Oak N73°W 94.64'  
 O.C. Remon. Tag & Nail in S.E. side P.P. S38°W 56.79'

Signed by Carl P. Englert Jr.  
 Surveyor's Michigan License No. 18987

Date 12/05/94

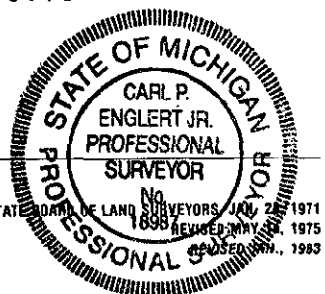

FORM APPROVED BY MICHIGAN STATE BOARD OF LAND SURVEYORS JAN. 23, 1971  
 1898 REVISED MAY, 1975  
 6-25 ED. 11-1983

LCRC Liber 1, Page 541 (7/20/72)  
D-5 Found 1 1/2" Pipe Raised with 5/8" Rod  
N.N.W. 20" Butternut  
S.W. 24" Poplar  
W.S.W. 24" Maple  
N.W. 40" oak

LCRC Liber 2, Page 828 (8/5/75)  
D-5 Steel Bar  
36" Oak NW 40.37'  
20" Maple SW 69.53'  
NE Hse. Cor. SW 106.20'  
NE Gar. Cor. SSE112.88'