

**SURVEY &
REMONUMENTATION**

APR 24 1995

COMMISSION

For corners in

**OTTAWA COUNTY REMONUMENTATION
LAND CORNER RECORDATION CERTIFICATE
Filing Requirement of Act 74, Mich. P.A. 1970**

RECORDED

94 DEC 15 AM 11:45

Daphne Redman
REGISTER OF DEEDS
OTTAWA COUNTY, MI

<u>Ottawa</u> (County)	Located In: Crockery Twp.	Corner Code #
1. Public Land Survey	T <u>8N</u> R <u>15W</u>	<u>D-7</u>
	T ___ R ___	<u>N 1/4 corner</u>
	T ___ R ___	<u>Section 20</u>
	T ___ R ___	_____
2. Property Controlling in Section	S ___ T ___ R ___	_____
	S ___ T ___ R ___	_____
3. Miscellaneous Property in Sec.	S ___ T ___ R ___	_____
	S ___ T ___ R ___	_____

Register of Deeds Stamp & File Number

4. Lot No. _____, Recorded Plat _____
5. Private Claims _____

	A	B	C	D	E	F	G	H	I	J	K	L	M
2	6		5		4		3		2		1		
3													
4	7		8		9		10		11		12		
5													
6	18		17		16		15		14		13		
7													
8	19		20		21		22		23		24		
9													
10	30		29		28		27		26		25		
11													
12	31		32		33		34		35		36		
13													

I, Carl P. Englert, in a field survey on November 23, 19 94, do hereby certify that under requirements of P.A. 74, Michigan P.A. of 1970, the corner points mentioned in lines 1 and 2 above were in conformance with regulations and rules therefore as required in the current manual of survey instructions of the United States Department of the Interior, Bureau of Land Management or by a decree of a Court of Law and/or that the corner points mentioned in lines 3, 4 and 5 above were in conformance with the rules of the Michigan Board of Land Surveyors or by a Decree of a Court of Law; established, re-established, monumented, re-monumented, recovered, found as expressed below:

NOTE: Not more than 4 corners, all in the same town and range, may be recorded on this certificate.

A. Description of original monument and accessories and/or subsequent restoration:

D-7 1/4 corner common to Sections 17 & 20.

Original corner set March 1837

by John Mullett

L.C.R.C. Liber 1, Page 541 07/72

Fd. 3/4" Rod in Mon. Box

South 56.20' P.P.

S.W. 45.62' 15" Cherry

North 38.63' 8" Cherry

N.W. 52.46' 9" Ash

Set Post

B. Oak 6" S52°E 15 Links

Do 6" N41°W 15 Links

B. Description of corner evidence found and/or method applied in restoring or reestablishing corner:

D-7 1/4 corner common to Sections 17 & 20.

Found 3/4" Iron bar in Mon. Box in $\frac{1}{2}$ Pavement 2" Deep

Found P.P. South 56.20'

Found 12" Ash N.W. 52.46' (No Nail)

PA. 345 OTTAWA COUNTY

PEER APPROVED 12/12/94

Harold P. Hedewald

Accepted as a careful and faithful perpetuation of the original position of the corner.

C. Description of monument for corner and accessories established to perpetuate locating the position of the corner:

D-7 1/4 corner common to Sections 17 & 20.


Set O.C. Remon. Cap on 3/4" Iron Bar in Mon. Box 6" Deep

O.C. Remon. Tag & Nail in S.W. side 12" Maple N45°W 45.75'

O.C. Remon. Tag & Nail in E. side 30" Oak N5°W 69.01'

O.C. Remon. Tag & Nail in W. side P.P. South 56.01'

O.C. Remon. Tag & Nail in N.W. side 10" Maple S45°W 43.55'

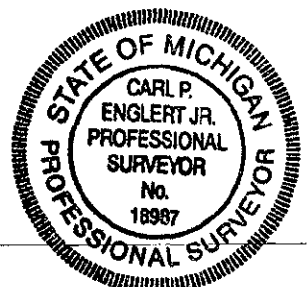

Signed by Carl P. Englert Jr.
Surveyor's Michigan License No. 18987

Date 12/1/94