

SURVEY & REMONUMENTATION

APR 24 1995

OTTAWA COUNTY REMONUMENTATION
LAND CORNER RECORDATION CERTIFICATE
 Filing Requirement of Act 74, Mich. P.A. 1970

RECORDED

94 DEC 15 AM 11:52

COMMISSION

For corners in

Phyllis Williams
 REGISTER OF DEEDS
 OTTAWA COUNTY, MI

<u>Ottawa</u> (County)	Located in: Crockery Twp.	Corner Code # <u>D-9</u>
1. Public Land Survey	T <u>8N</u> R <u>15W</u>	<u>S. 1/4 Corner</u> <u>Section 20</u>
	T _____ R _____	_____
	T _____ R _____	_____
	T _____ R _____	_____
2. Property Controlling in Section	S _____ T _____ R _____	_____
	S _____ T _____ R _____	_____
3. Miscellaneous Property in Sec.	S _____ T _____ R _____	_____
	S _____ T _____ R _____	_____

Register of Deeds Stamp & File Number

4. Lot No. _____, Recorded Plat _____
 5. Private Claims _____

	A	B	C	D	E	F	G	H	I	J	K	L	M
2	6	5	4	3	2	1							
3													
4	7	8	9	10	11	12							
5													
6	18	17	16	15	14	13							
7													
8	19	20	21	22	23	24							
9													
10	30	29	28	27	26	25							
11													
12	31	32	33	34	35	36							
13													

I, Carl P. Englert, in a field survey on May 17, 19 94, do hereby certify that under requirements of P.A. 74, Michigan P.A. of 1970, the corner points mentioned in lines 1 and 2 above were in conformance with regulations and rules therefore as required in the current manual of survey instructions of the United States Department of the Interior, Bureau of Land Management or by a decree of a Court of Law and/or that the corner points mentioned in lines 3, 4 and 5 above were in conformance with the rules of the Michigan Board of Land Surveyors or by a Decree of a Court of Law, established, re-established, monumented, re-monumented, recovered, found as expressed below:

NOTE: Not more than 4 corners, all in the same town and range, may be recorded on this certificate.

A. Description of original monument and accessories and/or subsequent restoration:

D-9 1/4 corner common to Sections 20 & 29
 Original Gov't corner set March, 1837
 by John Mullet, D.S.

LCRC, Liber 6, Page 197 (1/3/92)
 Fd. 1/2" R.R. over CIM
 Raised CIM
 28" Oak E. 33.53'
 8" Oak W. 74.92'
 P.P. N.W. 118.34'
 12" Hemlock S.E. 90.92'

(See Back of Page)

B. Description of corner evidence found and/or method applied in restoring or reestablishing corner:

D-9 1/4 corner common to Sections 20 & 29

Found 4" Harrison CIM
 Found 28" Oak East 33.53'
 Found 6" Oak West 74.92'
 Found P.P. N.W. 118.34'
 Found 12" Hemlock S.E. 90.82'

12.046 OTTAWA COUNTY
 PEER APPROVED, 12/12/94
Michael D. [Signature]

Accepted as a careful and faithful perpetuation of the original position of the corner.


C. Description of monument for corner and accessories established to perpetuate locating the position of the corner:

D-9 1/4 corner common to Sections 20 & 29

4" Harrison Cast Iron Monument, placed Mon. Box
 O.C. Remon. Tag & Nail in N. Side 6" Oak WEST 74.92'
 O.C. Remon. Tag & Nail in E. Side P.P. N27°W 118.28'
 O.C. Remon. Tag & Nail in N.W. Side P.P. S14°W 225.37'
 O.C. Remon. Tag & Nail in S.W. Side 10" Hemlock S30°E 90.88'
 O.C. Remon. Tag & Nail in S. Side 30" Oak EAST 34.94'

Signed by Carl P. Englert Jr
 Surveyor's Michigan License No. 18987

Date 12/7/94

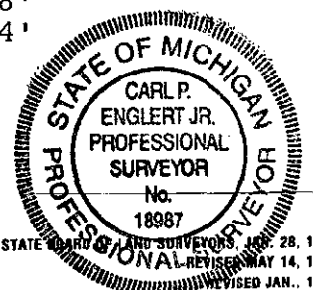

FORM APPROVED BY MICHIGAN STATE BOARD OF LAND SURVEYORS, MAY 14, 1975
 REVISED JAN., 1983

D-9 LCRC Liber 1, Page 429, (6/9/72)

Iron Pipe

24" B. Oak	E.	33.54'
14" Oak	S45°E	38.37'
16" B. Oak	S30°E	51.43'
P.P.	N.W.	118.30'

D-9 LCRC Liber 4, Page 59, (5/15/80)

Fd. 1" Pipe, Set CIM

24" Oak	E	33.54'
14" Oak	S45°E	38.27'
16" B. Oak	S30°E	51.43'
P.P.	N.W.	118.30'