

**SURVEY & REMONUMENTATION**

DEC 01 1998

**OTTAWA COUNTY REMONUMENTATION  
LAND CORNER RECORDATION CERTIFICATE  
Filing Requirement of Act 74, Mich. P.A. 1970**

**SECTION**

For corners in

Ottawa (County)	Located In:	Corner Code #
1. Public Land Survey	T 8 N R 15 W	D-13
	T _____ R _____	_____
	T _____ R _____	_____
	T _____ R _____	_____
2. Property Controlling in Section	S _____ T _____ R _____	South 1/4 corner Section 32
	S _____ T _____ R _____	Robinson Twp
3. Miscellaneous Property in Sec.	S _____ T _____ R _____	_____
	S _____ T _____ R _____	_____

**RECORDED**  
98 JUL 24 PM 1:44

*Darryl Schell*  
REGISTER OF DEEDS  
OTTAWA COUNTY, MI

Register of Deeds Stamp & File Number

4. Lot No. \_\_\_\_\_, Recorded Plat \_\_\_\_\_  
5. Private Claims \_\_\_\_\_

I, Steve Lampen, in a field survey on May 19 98, do hereby certify that under requirements of P.A. 74, Michigan P.A. of 1970, the corner points mentioned in lines 1 and 2 above were in conformance with regulations and rules therefore as required in the current manual of survey instructions of the United States Department of the Interior, Bureau of Land Management or by a decree of a Court of Law and/or that the corner points mentioned in lines 3, 4 and 5 above were in conformance with the rules of the Michigan Board of Land Surveyors or by a Decree of a Court of Law; established, re-established, monumented, re-monumented, recovered, found as expressed below:

	A	B	C	D	E	F	G	H	I	J	K	L	M
1													
2	6	5	4	3	2	1							
3													
4	7	8	9	10	11	12							
5													
6	18	17	16	15	14	13							
7													
8	19	20	21	22	23	24							
9													
10	30	29	28	27	26	25							
11													
12	31	32	33	34	35	36							
13													

NOTE: Not more than 4 corners, all in the same town and range, may be recorded on this certificate.

A. Description of original monument and accessories and/or subsequent restoration:  
D-13

GLO = Britain - 1832 West on South side of Section 32 40.00 set 1/2 mile post Pine 24" is post	Emmet Peck Pine stump 26"  LCRC-L2 P661-Englert-1974 Found 3/4" Rod in Mon. box NW 58.04 12" Oak N 43.03 Conc. mon. SE 78.18 Tel. pole SW 90.37 Tel. pole	LCRC-L5 P59-Schiele-1983 Steel bar in monument box Concrete monument N 43.00 Tel. pole SE 78.15 Tel. pole SW 90.31 16" Oak NW 57.98
--	---	--

B. Description of corner evidence found and/or method applied in restoring or reestablishing corner:  
D-13

Found cast iron monument in monument box  
Concrete monument N 43.00  
16" Oak NW 57.98

PA. 345 OTTAWA COUNTY  
RECORDED 6-15-98  
*YD 77*

Historically D-13 T8NR15W has been held as common with D-1 T7NR15W

This corner is used as D-13 T8NR15W in surveys recorded in L2 surveys P645, L2 surveys P920, L7 surveys P871.

This corner used as D-1 T7NR15W for surveys recorded in L1 surveys P460, L3 surveys P92, L7 surveys P822  
L2 surveys P636

D-13 T8NR15W is common with D-1 T7NR15W


Found cast iron monument is accepted as a careful and faithful perpetuation of the position of the original corner.

C. Description of monument for corner and accessories established to perpetuate locating the position of the corner:  
D-13

Cast iron monument in monument box. Corner is common to D-1 T7NR15W

Azimuth = Michigan State Plane Grid Direction.

Remonumentation tag in NW side	Power pole	214° 08'	131.87
Remonumentation tag in South side	16" Locust	100° 14'	236.53
SE corner house, siding		330° 33'	174.25
SW corner house, concrete block		26° 08'	142.01
Found concrete monument		359° 39'	43.00

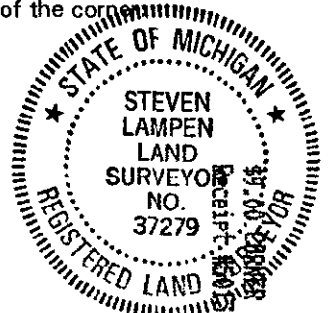

Signed by Steven Lampen Date JULY 20, 1998

Surveyor's Michigan License No. 37279

FORM APPROVED BY MICHIGAN STATE BOARD OF LAND SURVEYORS, JAN. 28, 1971  
REVISED MAY 14, 1975  
REVISED JAN., 1983  
ADAPTED FOR WORD PROCESSING MARCH, 1993