

FEB 24 2000

RECORDED

99 SEP 23 PM 3:21

SECTION

OTTAWA COUNTY REMONUMENTATION LAND CORNER RECORDATION CERTIFICATE Filing Requirement of Act 74, Mich. P.A. 1970

Darryl Schellert REGISTER OF DEEDS OTTAWA COUNTY, MI

For corners in Ottawa (County)

Located In: Crockery Township Corner Code #

- 1. Public Land Survey T8N R15W E-1 NW corner Section 4
2. Property Controlling in Section S T R
3. Miscellaneous Property in Sec. S T R

Register of Deeds Stamp & File Number

- 4. Lot No. , Recorded Plat
5. Private Claims

I, Carl P. Englert, in a field survey on 5/28, 1999 do hereby state that under requirements of P.A. 74, Michigan P.A. of 1970, the corner points mentioned in lines 1 and 2 above were in conformance with regulations and rules therefore as required in the current manual of survey instructions of the United States Department of the Interior, Bureau of Land Management or by a decree of a Court of Law and /or that the corner points mentioned in lines 3, 4 and 5 above were in conformance with the rules of the Michigan Board of Land Surveyors or by a Decree of a Court of Law; established, re-established, monumented, recovered, found as expressed below:

NOTE: Not more than 2 corners, all in the same town and range, may be recorded on this certificate.

Grid table with columns A-M and rows 1-13. Cell E-1 is circled.

A. Description of original monument and accessories and/or subsequent restoration: E-1 Corner common to Sections 4 & 5, T8N, R15W and Sections 32 & 33, T9N, R15W G.L.O. 1837, Mr. Mullett states: North between Sections 4 and 5 and intersected North Boundary at Post Hemlock 9" S70°W 12 Links Muskegon County Tie Book 1/2" Iron NW 111.32' P.P. SE 39.25' 10" App: SSW 32.87' 12" Pine WSW 71.94' 12" Pine See Other Side


B. Description of corner evidence found and/or method applied in restoring or reestablishing corner: E-1 Found Cast Iron Monument in Monument Box in Center of Asphalt Road Found 15" Apple SE 84.60' Found 15" Pine SW 48.18'

Accepted as a careful and faithful perpetuation of the original position of the corner.

C. Description of monument for corner and accessories established to perpetuate locating the position of the corner: E-1 Harrison Cast Iron Monument with Broken Top in Monument Box O.C. Remon Tag and Nail in W Side 18" Maple N 3°W 92.20' O.C. Remon Tag and Nail in SW Side Tele. Pole N52°W 109.35' O.C. Remon Tag and Nail in NW Side 15" Pine S48°W 48.22' O.C. Remon Tag and Nail in N Side 15" Apple S64°E 84.35' O.C. Remon Tag and Nail in S Side 12" Oak N74°E 95.70'

Signed by Carl P. Englert Jr Surveyor's Michigan License No. 18987

Date 8/13/1999

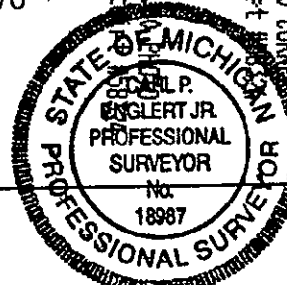

FEB 24 2000

SECTION

E-1, T8N, R15W

LCRC Liber 1023, Page 570, Muskegon County Records
 N.C. Jones, September 1973, recorded as E-13, T9N, R15W
 Found 1/2" Iron
 N60°W 111.32' Nail in P.P.
 S25°E 39.25' Nail in 12" Apple
 S10°W 32.87' Nail in 11" Pine
 S65°W 71.94' Nail in 13" Pine
 South 34.95' Nail in 12" Stump

LCRC Liber 1134, Page 261, Muskegon County Records
 Mr. Schiele, April, 1978, recorded as E-13, T9N, R15W
 Found 3/8" Steel Bar
 P.P. NW 111.40'
 10" Apple SE 39.21'
 12" Pine SSW 32.83'
 12" Pine WSW 71.96'


LCRC Liber 5, Page 47, Ottawa County Records
 Mr. Joiner, May 1983, Recorded as E-1, T8N, R15W
 Found Iron Bar in Monument Box
 Tele. Pole SW 40.70'
 11" Pine N 34.00'
 26" Maple NW 59.23'
 9" Maple WNW 86.65'

LCRC Liber 1810, Page 49, Muskegon County Remon. Records,
 Recorded as E-13, T9N, R15W by Mr. Vallier, December, 1994
 Found 2-3/4" Cast Iron Monument
 N54°W 111.40' Nail S. Side P.Pole
 S58°W 79.78' Nail S. Side 16" R. Pine
 S50°W 48.19' Nail N. Side 14" R. Pine
 S22°E 39.14' Nail W. Side 12" Apple
 S15°W 48.19' Nail W. Side 16" R. Pine
 S60°E 84.36' Nail N. Side 14" Apple

T9N, R15W

Sec. 32

Sec 33

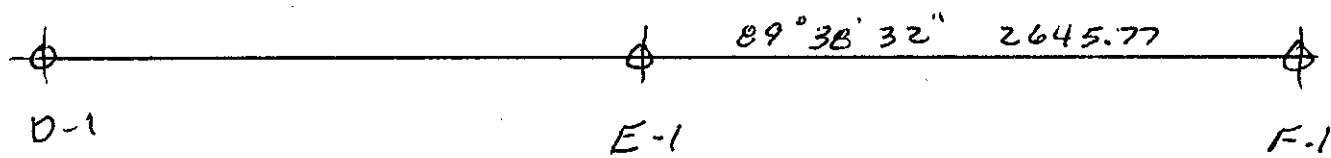

Sec 5

Sec 4

T8N, R15W

