

SURVEY & REMONUMENTATION

FEB 27 1998

OTTAWA COUNTY REMONUMENTATION
LAND CORNER RECORDATION CERTIFICATE
Filing Requirement of Act 74, Mich. P.A. 1970

RECORDED

97 OCT 30 AM 11:01

For corners in **SECTION**

<u>Ottawa</u>	Located In:	Corner Code #	
(County)	Crockery Township		
1. Public Land Survey	T <u>8N</u> R <u>15W</u>	<u>E-2</u>	
	T ___ R ___	<u>W 1/4 corner</u>	
	T ___ R ___	<u>Section 4</u>	
	T ___ R ___	_____	
2. Property Controlling in Section	S ___ T ___ R ___	_____	
	S ___ T ___ R ___	_____	
3. Miscellaneous Property in Sec.	S ___ T ___ R ___	_____	
	S ___ T ___ R ___	_____	

Debra Gant

Register of Deeds
Ottawa County, MI

Register of Deeds Stamp & File Number

4. Lot No. _____, Recorded Plat _____
5. Private Claims _____

I, Carl P. Englert, in a field survey on 2/28, 1997, do hereby state that under requirements of P.A. 74, Michigan P.A. of 1970, the corner points mentioned in lines 1 and 2 above were in conformance with regulations and rules therefore as required in the current manual of survey instructions of the United States Department of the Interior, Bureau of Land Management or by a decree of a Court of Law and /or that the corner points mentioned in lines 3, 4 and 5 above were in conformance with the rules of the Michigan Board of Land Surveyors or by a Decree of a Court of Law, established, re-established, monumented, recovered, found as expressed below:

	A	B	C	D	E	F	G	H	I	J	K	L	M
1													
2		6		5	4			3		2			1
3													
4		7		8	9			10		11			12
5													
6		18		17	16			15		14			13
7													
8		19		20	21			22		23			24
9													
10		30		29	28			27		26			25
11													
12		31		32	33			34		35			36
13													

NOTE: Not more than 2 corners, all in the same town and range, may be recorded on this certificate.

A. Description of original monument and accessories and/or subsequent restoration:

E-2 1/4 corner common to Sections 4 and 5 G.L.O. 1837 John Mullett Set 1/4 Section Post Beech 8" S35°W 25 links Beech 15" N25°E 12 links	LCRC Liber 2, Page 339 10/30/73 Found 6"x8" R.R. Tie for Corner Fence Post at the Intersection of Field & Fence lines in a N.S. E.&W. direction Set 3/4" ID Pipe at SE Corner of Fence Post N 11.8' R.R. Tie Fence Post E 12.2' R.R. Tie Fence Post W 51.8' 15" Apple
--	--

See Other Side

B. Description of corner evidence found and/or method applied in restoring or reestablishing corner:


E-2 1/4 corner common to Sections 4 and 5 Found 3/4" Pipe at Fence Corner Found R.R. Tie Fence Post N. 11.8' Found 15" Apple West 51.8' Fence & Field lines N, S, E & W	P.A. 345 OTTAWA COUNTY PEER APPROVED <u>9-15-97</u>
---	--

Accepted as a careful and faithful perpetuation of the original position of the corner.

C. Description of monument for corner and accessories established to perpetuate locating the position of the corner:

E-2 1/4 corner common to Sections 4 and 5

Set 3' long 3/4" Iron Bar with O.C. Remon Cap	
O.C. Remon Tag & Nail in S Side 18" Apple	S90°W 52.70'
O.C. Remon Tag & Nail in E Side 7" Sassafras	S 50°E 7.30'
O.C. Remon Tag & Nail in N Side Twin 8" Maple	S83°E 36.89'
O.C. Remon Tag & Nail in W Side 7" Pepperidge	N27°E 25.57'

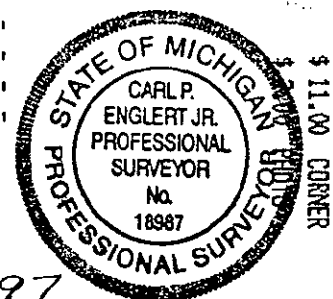

Signed by Carl P. Englert Jr.
Surveyor's Michigan License No. 18987

Date 9/15/1997

W 1/4 corner Section 4
Town 8 North, Range 15 West
LCRC Liber 4, Page 34 1/30/80
Found 3/4" Pipe with R.R. Tie along side and to the N.E.

**SURVEY &
REMONUMENTATION**

FEB 27 1998

SECTION