

SURVEY & REMONUMENTATION

APR 24 1995

**OTTAWA COUNTY REMONUMENTATION
LAND CORNER RECORDATION CERTIFICATE
Filing Requirement of Act 74, Mich. P.A. 1970**

RECORDED
94 DEC 15 AM 11:52

For corners in **COMMISSION**

Phyllis Culman
REGISTER OF DEEDS
OTTAWA COUNTY, MI

Ottawa (County) Located In: Crockery Twp. Corner Code: #

1. Public Land Survey	T <u>8N</u> R <u>15W</u>	<u>E-4</u>
	T _____ R _____	<u>E. 1/4 Corner</u>
	T _____ R _____	<u>Section 8</u>
	T _____ R _____	_____
2. Property Controlling in Section	S _____ T _____ R _____	_____
	S _____ T _____ R _____	_____
3. Miscellaneous Property in Sec.	S _____ T _____ R _____	_____
	S _____ T _____ R _____	_____
4. Lot No. _____, Recorded Plat _____		
5. Private Claims _____		

Register of Deeds Stamp & File Number

A	B	C	D	E	F	G	H	I	J	K	L	M
2	6	5	4	3	2	1						
3												
4	7	8	▲	9	10	11	12					
5												
6	18	17	16	15	14	13						
7												
8	19	20	21	22	23	24						
9												
10	30	29	28	27	26	25						
11												
12	31	32	33	34	35	36						
13												

I, Carl P. Englert, in a field survey on December 02, 19 94, do hereby certify that under requirements of P.A. 74, Michigan P.A. of 1970, the corner points mentioned in lines 1 and 2 above were in conformance with regulations and rules therefore as required in the current manual of survey instructions of the United States Department of the Interior, Bureau of Land Management or by a decree of a Court of Law and/or that the corner points mentioned in lines 3, 4 and 5 above were in conformance with the rules of the Michigan Board of Land Surveyors or by a Decree of a Court of Law; established, re-established, monumented, re-monumented, recovered, found as expressed below:

NOTE: Not more than 4 corners, all in the same town and range, may be recorded on this certificate.

A. Description of original monument and accessories and/or subsequent restoration:

E-4 1/4 corner common to Sections 8 & 9
Original Gov't corner set March 1837
by John Mullet D.S.

Set 1/4 Section Post
Hemlock 9" S87°E 7 Links
Beech 8" N63°W 12 Links

LCRC Liber 4, Page 243 (10/30/81)
E-4 Set Cast Iron Monument
13" Apple NE 43.05'
7" Apple SSE 99.15'
6" Sassafrass SW 49.97'
6" Sassafrass WSW 60.49'

(See Back of Page)

B. Description of corner evidence found and/or method applied in restoring or reestablishing corner:

E-4 1/4 corner common to Sections 8 & 9

Found 4" Harrison CIM 2" Deep
Found 13" Apple NE 43.05'
Found 6" Sassafrass SW 49.97'
Found 6" Sassafrass WSW 60.49'

P.A. 345 OTTAWA COUNTY
PEER APPROVED 12/12/94

Robert D. Nedewald

Accepted as a careful and faithful perpetuation of the original position of the corner.


C. Description of monument for corner and accessories established to perpetuate locating the position of the corner:

E-4 1/4 corner common to Sections 8 & 9

4" Harrison Cast Iron Mon.
O.C. Remon. Tag & Nail in W. side 15" Apple N25°W 43.06'
O.C. Remon. Tag & Nail in N. side 10" Sassafrass S49°W 60.25'
O.C. Remon. Tag & Nail in W. side 12" Sassafrass S24°W 50.01'
O.C. Remon. Tag & Nail in S. side 12" Pine S80°E 104.40'

Signed by Carl P. Englert Jr.
Surveyor's Michigan License No. 18987

Date 12/11/94

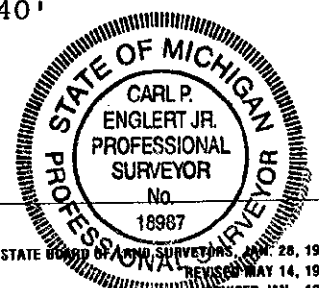

FORM APPROVED BY MICHIGAN STATE BOARD OF LAND SURVEYORS, MAY 28, 1971
REVISED MAY 14, 1975
REVISED JAN., 1983

LCRC Liber 3, Page 169

E-4 Pinched Iron Pipe

Nail in face of	13" Apple	N.E.	42.39'
Nail in face of	7" Apple	S.S.E.	99.17'
Nail in face of	6" Sassafrass	S.W.	50.02'

1000

