

SURVEY & REMONUMENTATION

APR 24 1995

COMMISSION

OTTAWA COUNTY REMONUMENTATION
LAND CORNER RECORDATION CERTIFICATE
 Filing Requirement of Act 74, Mich. P.A. 1970

RECORDED

94 DEC 15 AM 11:52

Dyckie Kullman
 REGISTER OF DEEDS
 OTTAWA COUNTY, MI

For corners in

Ottawa (County) Located In: Crockery Twp. Corner Code #

1. Public Land Survey T 8N R 15W E-9
 T ___ R ___ S.W. Corner
 T ___ R ___ Section 21
 T ___ R ___

2. Property Controlling S ___ T ___ R ___
 in Section S ___ T ___ R ___

3. Miscellaneous S ___ T ___ R ___
 Property in Sec. S ___ T ___ R ___

4. Lot No. _____, Recorded Plat _____

5. Private Claims _____

Register of Deeds Stamp & File Number

A	B	C	D	E	F	G	H	I	J	K	L	M
2	6	5	4	3	2	1						
3												
4	7	8	9	10	11	12						
5												
6	18	17	16	15	14	13						
7												
8	19	20	21	22	23	24						
9												
10	30	29	28	27	26	25						
11												
12	31	32	33	34	35	36						
13												

I, Carl P. Englert, in a field survey on December 07, 1994, do hereby certify that under requirements of P.A. 74, Michigan P.A. of 1970, the corner points mentioned in lines 1 and 2 above were in conformance with regulations and rules therefore as required in the current manual of survey instructions of the United States Department of the Interior, Bureau of Land Management or by a decree of a Court of Law and/or that the corner points mentioned in lines 3, 4 and 5 above were in conformance with the rules of the Michigan Board of Land Surveyors or by a Decree of a Court of Law, established, re-established, monumented, re-monumented, recovered, found as expressed below:

NOTE: Not more than 4 corners, all in the same town and range, may be recorded on this certificate.

A. Description of original monument and accessories and/or subsequent restoration:

E-9 corner common to Sections 20, 21, 28 & 29
 Original Gov't corner set March, 1837
 by John Mullet D.S.

LCRC Liber 4, Page 72 (5/28/80)
 Set Cast Iron Monument
 Inscribed "Section Corner"
 3" Twin Poplar W,SW 1.80'
 Quad. 5" Elm EAST 28.15'
 Corner D-9 WEST 2647.55'

(See back of page)

B. Description of corner evidence found and/or method applied in restoring or reestablishing corner:

E-9 corner common to Sections 20, 21, 28 & 29

Found 4" Harrison CIM & Steel Fence Post (Mon. 6" under water)
 Found 3" Tw. Ash W,SW 1.80'
 Found 5" Quad Ash E. 28.15'

P.A. 345 OTTAWA COUNTY

PEER APPROVED

12/12/94

Keddy D. Newswell

Accepted as a careful and faithful perpetuation of the original position of the corner.

C. Description of monument for corner and accessories established to perpetuate locating the position of the corner:

E-9 corner common to Sections 20, 21, 28 & 29

4" Harrison Cast Iron Mon.
 O.C. Remon. Tag & Nail in N. side 6" Quad Ash EAST 27.92'
 O.C. Remon. Tag & Nail in E. side 6" Ash N20°W 45.25'
 O.C. Remon. Tag & Nail in N. side 5" Ash N20°W 33.23'
 O.C. Remon. Tag & Nail in N. side 4" Trip. Ash S50°W 1.65'

Signed by


Carl P. Englert

Date

12/11/94

Surveyor's Michigan License No. _____

FORM APPROVED BY MICHIGAN STATE BOARD OF SURVEYORS, JAN 23, 1971

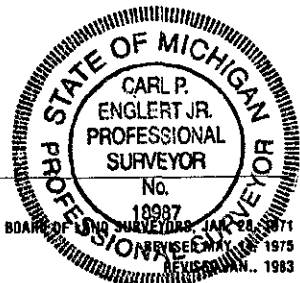

LCRC Liber 3, Page 248 (1/16/78)

E-9 Iron Pipe with Fence Post Next To it	
Nail in N. side of 3" Twin Popple	W.S.W. 1.80'
Nail in s. side of Quadruple 5" Elm	E. 28.15'
P.K. Nail	S.S.E. 526.70'

LCRC Liber 1, Page 429 (5/25/72)

Iron Pipe with Fence Post Next to it.