

SURVEY & REMONUMENTATION

APR 24 1995

OTTAWA COUNTY REMONUMENTATION LAND CORNER RECORDATION CERTIFICATE

RECORDED

94 DEC 15 AM 11:52

COMMISSION

Filing Requirement of Act 74, Mich. P.A. 1970

For corners in

Politically Robinson Twp.

Edmund Hollman
REGISTER OF DEEDS
OTTAWA COUNTY, MI

Ottawa
(County)

Located In: Corner Code #
Crockery Twp.

- | | | |
|------------------------------------|--------------------------|-------------------|
| 1. Public Land Survey | T <u>8N</u> R <u>15W</u> | <u>E-13</u> |
| | T _____ R _____ | <u>SW Corner</u> |
| | T _____ R _____ | <u>Section 33</u> |
| | T _____ R _____ | _____ |
| 2. Property Controlling in Section | S _____ T _____ R _____ | _____ |
| | S _____ T _____ R _____ | _____ |
| 3. Miscellaneous Property in Sec. | S _____ T _____ R _____ | _____ |
| | S _____ T _____ R _____ | _____ |

Register of Deeds Stamp & File Number

4. Lot No. _____, Recorded Plat _____
5. Private Claims _____

	A	B	C	D	E	F	G	H	I	J	K	L	M
2	6	5	4	3	2	1							
3													
4	7	8	9	10	11	12							
5													
6	18	17	16	15	14	13							
7													
8	19	20	21	22	23	24							
9													
10	30	29	28	27	26	25							
11													
12	31	32	33	34	35	36							
13													

I, Carl P. Englert, in a field survey on December 01, 19 94, do hereby certify that under requirements of P.A. 74, Michigan P.A. of 1970, the corner points mentioned in lines 1 and 2 above were in conformance with regulations and rules therefore as required in the current manual of survey instructions of the United States Department of the Interior, Bureau of Land Management or by a decree of a Court of Law and/or that the corner points mentioned in lines 3, 4 and 5 above were in conformance with the rules of the Michigan Board of Land Surveyors or by a Decree of a Court of Law; established, re-established, monumented, re-monumented, recovered, found as expressed below:

NOTE: Not more than 4 corners, all in the same town and range, may be recorded on this certificate.

A. Description of original monument and accessories and/or subsequent restoration:
E-13 corner common to Sections 32 & 33

Original Gov't corner Set May 1832
by Calvin Britain D.S.

LCRC Liber 5, Page 59 (7/22/83)
E-13 Cast Iron Monument
44" Oak ESE 23.64'
20" Oak SE 42.60'
S. Hse. Line
ext. W S 0.65'
Tel Pole WSW 81.42'
28" Oak NNW 86.50'

Set corner to Section 32 & 33
Pine 30" N28°W 47 Links
Pine 28" N89°E 73 Links

(See Back of Page)

B. Description of corner evidence found and/or method applied in restoring or reestablishing corner:
E-13 corner common to Sections 32 & 33

Found 4" Harrison CIM 10" deep
Found 48" Oak S.E. 23.66'
Found 28" Oak N.N.W. 86.50'


PA. 345 OTTAWA COUNTY
PEER APPROVED 12/12/94
Maday D. [Signature]

Accepted as a careful and faithful perpetuation of the original position of the corner.

C. Description of monument for corner and accessories established to perpetuate locating the position of the corner:
E-13 corner common to Sections 32 & 33

4" Harrison Cast Iron Mon.
O.C. Remon. Tag & Nail in N.W. side 22" Oak N43°E 41.27'
O.C. Remon. Tag & Nail in W. side 30" Oak N24°W 87.50'
O.C. Remon. Tag & Nail in S.W. side 44" Oak S65°E 25.42'
O.C. Remon. Tag & Nail in N.W. side 19" W. Pine S32°W 71.26'

Signed by Carl P. Englert Jr. Date 12/5/94
Surveyor's Michigan License No. 18987

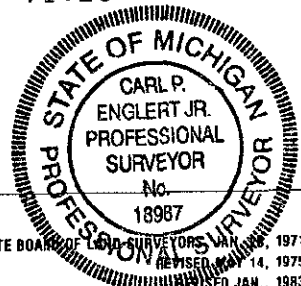

FORM APPROVED BY MICHIGAN STATE BOARD OF LAND SURVEYORS, JAN. 14, 1975
REVISED JAN., 1983

LCRC Liber 2, Page 661 (10/8/74)

E-13 (Found) Cast Iron Mon.

S.E. 23.66 48" Oak

S.S.E. 42.60 16" Oak

W. 81.35 T.P.

N. 86.51 36" Oak