

**SURVEY &
REMONUMENTATION**

APR 24 1995

**OTTAWA COUNTY REMONUMENTATION
LAND CORNER RECORDATION CERTIFICATE**

RECORDED

94 DEC 15 AM 11:49

For corners in **COMMISSION**

Filing Requirement of Act 74, Mich. P.A. 1970

D. Lyndell Williams
REGISTER OF DEEDS
OTTAWA COUNTY, MI

<u>Ottawa</u> (County)	Located In: Crockery Twp.	Corner Code #
1. Public Land Survey	T <u>8N</u> R <u>15W</u>	<u>F-7</u>
	T _____ R _____	<u>N 1/4 Corner</u>
	T _____ R _____	<u>Section 21</u>
	T _____ R _____	_____
2. Property Controlling in Section	S _____ T _____ R _____	_____
	S _____ T _____ R _____	_____
3. Miscellaneous Property in Sec.	S _____ T _____ R _____	_____
	S _____ T _____ R _____	_____

Register of Deeds Stamp & File Number

4. Lot No. _____, Recorded Plat _____
5. Private Claims _____

A	B	C	D	E	F	G	H	I	J	K	L	M
2	6	5	4	3	2	1						
3												
4	7	8	9	10	11	12						
5												
6	18	17	16	15	14	13						
7												
8	19	20	21	22	23	24						
9												
10	30	29	28	27	26	25						
11												
12	31	32	33	34	35	36						
13												

I, Carl P. Englert in a field survey on November 23, 19 94, do hereby certify that under requirements of P.A. 74, Michigan P.A. of 1970, the corner points mentioned in lines 1 and 2 above were in conformance with regulations and rules therefore as required in the current manual of survey instructions of the United States Department of the Interior, Bureau of Land Management or by a decree of a Court of Law and/or that the corner points mentioned in lines 3, 4 and 5 above were in conformance with the rules of the Michigan Board of Land Surveyors or by a Decree of a Court of Law; established, re-established, monumented, re-monumented, recovered, found as expressed below:

NOTE: Not more than 4 corners, all in the same town and range, may be recorded on this certificate.

A. Description of original monument and accessories and/or subsequent restoration:

F-7 1/4 corner common to Section 16 & 21
Original Gov't corner set March 1837
by John Mullet

Set Post
Hemlock 9" N16°W 22 Links
Do 7" S16°E 5 Links

L.C.R.C. Liber 2, Page 341, Oct. 1973
Found 1/2" Iron in Mon. Box
N20°E 35.09' M.D.S.H. Tag in 11" Maple
S25°E 64.68' Face of St. Sign Post
S35°W 69.13' Top center of Conc.
R/W Marker

B. Description of corner evidence found and/or method applied in restoring or reestablishing corner:


F-7 1/4 corner common to Sections 16 & 21
Found 1/2" Boat Spike in Mon. Cox 4" deep 1.5'+/- N. of E pavement.
Found Broken R/W Marker S35°W 69'+/-

P.A. 345 OTTAWA COUNTY
PEER APPROVED 12/12/94
Harold D. Hedwood

Accepted as a careful and faithful perpetuation of the original position of the corner.

C. Description of monument for corner and accessories established to perpetuate locating the position of the corner:

F-7 1/4 corner common to Sections 16 & 21
Set O.C. Remon. Cap on 3/4" x 2' Iron bar in Mon. Box
O.C. Remon. Tag & Nail in N.W. side P.P. S25°W 62.95'
O.C. Remon. Tag & Nail in N.E. side 8" Pine S45°E 86.00'
O.C. Remon. Tag & Nail in N.W. side 12" Pine N40°E 57.00'
O.C. Remon. Tag & Nail in W. side P.P. N30°W 56.48'
Top center of Hydrant N4°E 54.60'

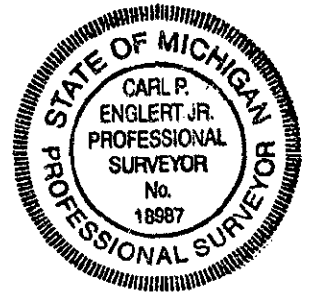

Signed by Carl P. Englert Jr.
Surveyor's Michigan License No. 18987

Date 12/1/94