

SURVEY & REMONUMENTATION

APR 24 1995

OTTAWA COUNTY REMONUMENTATION
LAND CORNER RECORDATION CERTIFICATE
Filing Requirement of Act 74, Mich. P.A. 1970

RECORDED

94 DEC 15 AM 11:52

COMMISSION

For corners in

Edythe K. Holman
REGISTER OF DEEDS
OTTAWA COUNTY, MI

Ottawa (County)	Located In:	Corner Code #
	Crockery Twp.	
1. Public Land Survey	T 8N R 15W	F-9
	T _____ R _____	S 1/4 Corner
	T _____ R _____	Section 21
	T _____ R _____	
2. Property Controlling in Section	S _____ T _____ R _____	
	S _____ T _____ R _____	
3. Miscellaneous Property in Sec.	S _____ T _____ R _____	
	S _____ T _____ R _____	

Register of Deeds Stamp & File Number

4. Lot No. _____, Recorded Plat _____
5. Private Claims _____

	A	B	C	D	E	F	G	H	I	J	K	L	M
2	6	5	4	3	2	1							
3													
4	7	8	9	10	11	12							
5													
6	18	17	16	15	14	13							
7													
8	19	20	21	22	23	24							
9													
10	30	29	28	27	26	25							
11													
12	31	32	33	34	35	36							
13													

I, Carl P. Englert in a field survey on December 07, 19 94, do hereby certify that under requirements of P.A. 74, Michigan P.A. of 1970, the corner points mentioned in lines 1 and 2 above were in conformance with regulations and rules therefore as required in the current manual of survey instructions of the United States Department of the Interior, Bureau of Land Management or by a decree of a Court of Law and/or that the corner points mentioned in lines 3, 4 and 5 above were in conformance with the rules of the Michigan Board of Land Surveyors or by a Decree of a Court of Law; established, re-established, monumented, re-monumented, recovered, found as expressed below:

NOTE: Not more than 4 corners, all in the same town and range, may be recorded on this certificate.

A. Description of original monument and accessories and/or subsequent restoration:

F-9 1/4 corner common to Sections 21 & 28
Original Gov't corner set March, 1837
by John Mullet D.S.

Set 1/4 Section Post
B. Oak 9" N78°W 20 Links
Sugar 6" S83°W 31 Links

(See Back of Page)

B. Description of corner evidence found and/or method applied in restoring or reestablishing corner:

F-9 1/4 corner common to Sections 21 & 28

Found 4" Harrison CIM at ground level 3'+/- South of Fence corner
Found 10" W. Oak S70°W 39.44'
Found 18" S.B. Hickory S80°W 48.30'
Found 6" Sassafras S40°E 14.32' (Dead)

P.A. 245 OTTAWA COUNTY
PEER APPROVED 12/12/94
Hydoy D. Nedewell


Accepted as a careful and faithful perpetuation of the original position of the corner.

C. Description of monument for corner and accessories established to perpetuate locating the position of the corner:

F-9 1/4 corner common to Sections 21 & 28

4" Harrison Cast Iron Mon.
O.C. Remon. Tag & Nail in N. side 17" Maple N80°E 10.17'
O.C. Remon. Tag & Nail in W. side 12" Trip. Maple N 6°E 31.62'
O.C. Remon. Tag & Nail in S.W. side 10" Tw. Maple N45°W 4.62'
O.C. Remon. Tag & Nail in S. side 8" Apple S80°W 20.18'

Signed by Carl P. Englert Date 12/11/94
Surveyor's Michigan License No. 18987

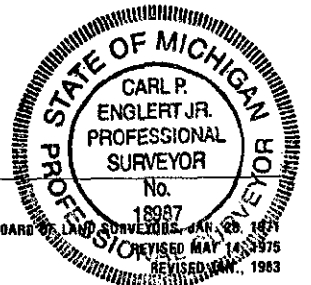

FORM APPROVED BY MICHIGAN STATE BOARD OF LAND SURVEYORS, JAN 28 1987, REVISED MAY 14 1975, REVISED JAN 1983

LCRC Liber 1, Page 291 (3/8/72)

Found Iron Plow Point

Set Cast Iron Monument Inscribed

"Ottawa County Section Corner"

10" White Oak	S70°W	39.44'
18" Shag Bark Hickory	S80°W	48.30'
18" Maple	N80°E	52.28'
6" Sassafrass	S40°E	14.32'

R.R. spike in E Leonard Road on the North
and South 1/4 Line, Section 21,

NORTH 590.03'

RECORDED
INDEXED
MAR 10 1972
LCRC