

FEB 24 2000

RECORDED

SECTION

OTTAWA COUNTY REMONUMENTATION
LAND CORNER RECORDATION CERTIFICATE
Filing Requirement of Act 74, Mich. P.A. 1970

99 SEP 23 PM 3: 21

For corners in

| | | |
|---------------------------------------|---|------------------|
| <u>Ottawa</u> (County) | Located In: | Corner Code # |
| | Crockery Township | |
| 1. Public Land Survey | T <u>8N</u> R <u>15W</u> | <u>G-1</u> |
| | T <u> </u> R <u> </u> | <u>NW corner</u> |
| | T <u> </u> R <u> </u> | <u>Section 3</u> |
| | T <u> </u> R <u> </u> | |
| 2. Property Controlling in Section | S <u> </u> T <u> </u> R <u> </u> | |
| | S <u> </u> T <u> </u> R <u> </u> | |
| 3. Miscellaneous Property in Sec. | S <u> </u> T <u> </u> R <u> </u> | |
| | S <u> </u> T <u> </u> R <u> </u> | |

Ray Mullett
REGISTER OF DEEDS
OTTAWA COUNTY, MI

Register of Deeds Stamp & File Number

4. Lot No. _____, Recorded Plat _____
5. Private Claims _____

I, Carl P. Englert, in a field survey on 5/28, 1999 do hereby state that under requirements of P.A. 74, Michigan P.A. of 1970, the corner points mentioned in lines 1 and 2 above were in conformance with regulations and rules therefore as required in the current manual of survey instructions of the United States Department of the Interior, Bureau of Land Management or by a decree of a Court of Law and /or that the corner points mentioned in lines 3, 4 and 5 above were in conformance with the rules of the Michigan Board of Land Surveyors or by a Decree of a Court of Law; established, re-established, monumented, recovered, found as expressed below:

NOTE: Not more than 2 corners, all in the same town and range, may be recorded on this certificate.

| | | | | | | | | | | | | | |
|----|----|----|----|----|----|----|---|---|---|---|---|---|---|
| | A | B | C | D | E | F | G | H | I | J | K | L | M |
| 1 | | | | | | | ⊙ | | | | | | |
| 2 | 6 | 5 | 4 | 3 | 2 | 1 | | | | | | | |
| 3 | | | | | | | | | | | | | |
| 4 | 7 | 8 | 9 | 10 | 11 | 12 | | | | | | | |
| 5 | | | | | | | | | | | | | |
| 6 | 18 | 17 | 16 | 15 | 14 | 13 | | | | | | | |
| 7 | | | | | | | | | | | | | |
| 8 | 19 | 20 | 21 | 22 | 23 | 24 | | | | | | | |
| 9 | | | | | | | | | | | | | |
| 10 | 30 | 29 | 28 | 27 | 26 | 25 | | | | | | | |
| 11 | | | | | | | | | | | | | |
| 12 | 31 | 32 | 33 | 34 | 35 | 36 | | | | | | | |
| 13 | | | | | | | | | | | | | |

A. Description of original monument and accessories and/or subsequent restoration:

G-1 Corner common to Sections 3 & 4, T8N, R15W and Sections 33 & 34, T9N, R15W

G.L.O. Mr. Mullett states: North between Sections 3 and 4 and intersected North Boundary at Post Hemlock 14" S73°W 12 links

Muskegon County Tie Book
3/4" Iron in Mon. Box
SW 50.95' St. Sign
NE 46.86' Fence Post
SE 71.12' 16" Pine SE 44.85' T.P.

See Other Side

B. Description of corner evidence found and/or method applied in restoring or reestablishing corner:

G-1 Found 3" Cast Iron Monument in Monument Box on Center of Roads North-South and East-West Roads

Found 20" Ash NW 113.46'
Found 24" W. Pine NW 51.5'±(No Nail)
Found 12" W. Pine NE 51.24'

Accepted as a careful and faithful perpetuation of the original position of the corner.

8/16/99
[Signature]

C. Description of monument for corner and accessories established to perpetuate locating the position of the corner:

G-1 3" Cast Iron Monument in Monument Box

| | | | |
|---------------------------------------|-------------|-------|---------|
| O.C. Remon Tag and Nail in South Side | 20" Oak | N76°W | 113.49' |
| O.C. Remon Tag and Nail in NE Side | 24" W. Pine | N38°W | 51.28' |
| O.C. Remon Tag and Nail in NW Side | 12" W. Pine | N32°W | 54.14' |
| O.C. Remon Tag and Nail in West Side | P.P. | S38°E | 94.30' |
| O.C. Remon Tag and Nail in East Side | 8" Pine | S34°W | 100.88' |

Signed by Carl P. Englert
Surveyor's Michigan License No. 18987

Date 9/13/1999



24.00 FRUIT
Receipt #58324
\$11.00 CORNER
Receipt #58324

FEB 24 2000

SECTION

G-1 T8N, R15W

LCRC Liber 1134, Page 262, Muskegon County Records
 Mr. Schiele, March 1978, Recorded as G-13, T9N, R15W
 Found 3/8" Steel bar in Mon. Box
 22" Pine SE 71.12'
 Tel. Pole SE 44.52'
 20" Ash NW 113.46'
 24" Maple NE 129.85'


LCRC Liber 5, Page 45 Mr. Joiner, May 1983
 Found "T" Iron in Monument Box
 Set C.I.M.
 8" W. Pine NW 51.50'
 4" W. Pine NE 54.24'
 18" Tree WNW 113.50'
 T.P. SE 44.52'

LCRC Liber 1810, Page 38, Muskegon County Records
 Mr. Vallier, December 1994, Recorded as G-13, T9N, R15W
 Found 2-3/4" Cast Iron Mon. with County Survey Cap in Monument Box
 N43°E 54.26' Nail in N. Side 12" W. Pine
 S35°E 94.58' Nail in S. Side P. Pole
 S35°W 93.92' Nail in N. Side 6" Red Pine
 N35°W 51.37' Nail in N. Side 20" W. Pine
 N73°W 113.46' Nail in N. Side 22" Ash

Sec. 33

T9N, R15W

Sec 34

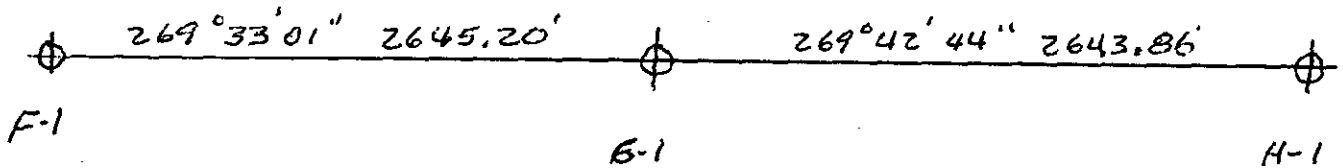

Sec. 4

T8N, R15W



Sec 3