

SURVEY &  
REMONUMENTATION

APR 05 1996

OTTAWA COUNTY REMONUMENTATION  
COMMISSION LAND CORNER RECORDATION CERTIFICATE  
Filing Requirement of Act 74, Mich. P.A. 1970

RECORDED

95 DEC 12 PM 4: 53

*Robert C. Blomman*  
REGISTER OF DEEDS  
OTTAWA COUNTY, MI

For corners in Crockery Twp.  
Ottawa (County) Located In: Corner Code #

1. Public Land Survey	T <u>8N</u> R <u>15W</u>	G-6
	T ___ R ___	W $\frac{1}{4}$ Corner
	T ___ R ___	Section 15
	T ___ R ___	_____
2. Property Controlling in Section	S ___ T ___ R ___	_____
	S ___ T ___ R ___	_____
3. Miscellaneous Property in Sec.	S ___ T ___ R ___	_____
	S ___ T ___ R ___	_____

4. Lot No. \_\_\_\_\_, Recorded Plat \_\_\_\_\_  
5. Private Claims \_\_\_\_\_

Register of Deeds Stamp & File Number

I, Carl P. Englert, Jr., in a field survey on October 9, 1995 do hereby state that under requirements of P.A. 74, Michigan P.A. of 1970, the corner points mentioned in lines 1 and 2 above were in conformance with regulations and rules therefore as required in the current manual of survey instructions of the United States Department of the Interior, Bureau of Land Management or by a decree of a Court of Law and /or that the corner points mentioned in lines 3, 4 and 5 above were in conformance with the rules of the Michigan Board of Land Surveyors or by a Decree of a Court of Law; established, re-established, monumented, recovered, found as expressed below:

NOTE: Not more than 2 corners, all in the same town and range, may be recorded on this certificate.

A	B	C	D	E	F	G	H	I	J	K	L	M
1												
2	6		5		4		3		2		1	
3												
4	7		8		9		10		11		12	
5												
6	18		17		16	15	14		13			
7												
8	19		20		21		22		23		24	
9												
10	30		29		28		27		26		25	
11												
12	31		32		33		34		35		36	
13												

A. Description of original monument and accessories and/or subsequent restoration:

G-6  $\frac{1}{4}$  Corner common to Sections 15 & 16  
Original Gov't corner set March 1837  
by John Mullett  
Set  $\frac{1}{4}$  Section Post  
Pine 22" S 70° W 33 Links

LCRC Liber 2, Page 343, 9/10/1973  
Found 3/4" Pinched Pipe  
N 50° E 34.83' Face of Sta. Sign. Post  
East 52.97' Nail in 28" Apple  
S 65° E 47.45' Nail in 15" Oak  
N 50° W 90.44' SE Cor Hse Foundation

See other side

B. Description of corner evidence found and/or method applied in restoring or reestablishing corner:

G-6  $\frac{1}{4}$  Corner common to Sections 15 & 16  
Found 3" Cast Iron Monument with Broken top  
Found 20" Oak East 45.64'  
Found 10" Spruce NW 54.20'  
Found 8" Maple NE 39.61'  
Found 9" Tw. Oak SE 59.98'

RA. 345 OTTAWA COUNTY  
REPR APPROVED 12/11/95  
*Richard D. Nedewell*  
RDN

Accepted as a careful and faithful perpetuation of the position of the original corner.


C. Description of monument for corner and accessories established to perpetuate locating the position of the corner:

G-6  $\frac{1}{4}$  Corner common to Sections 15 & 16  
3" CIM with broken top 6'± E of CL of Gravel Road.

Ottawa County Remonumentation tag and nail in N. Side	20" Oak	N 90° E 45.71'
Ottawa County Remonumentation tag and nail in N. Side	9" Oak	S 58° E 59.96'
Ottawa County Remonumentation tag and nail in N. Side	10" Maple	N 69° E 39.71'
Ottawa County Remonumentation tag and nail in E. Side	10" Spruce	N 27° W 54.02'
Ottawa County Remonumentation tag and nail in N. Side	8" Tw. Locust	S 74° W 65.44'

Signed by Carl P. Englert Jr.  
Surveyor's Michigan License No. 18987

Date 12/8/1995

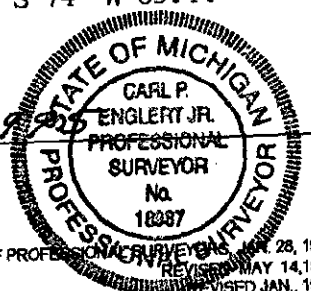

LCRC Liber 2, Page 407 December 29, 1973

Fd. 1" Pipe

SE 47.42' 13" Pepperridge

NE 39.61' 6" Maple

NE 34.95' St. Sign

NW 61.81' Centerline of 5" Maple

LCRC Liber 4, Page 28 January 24, 1980

Fd 3 - 1" Pinched Pipes with Plowpoint Below

Set CIM

Set tie nail in side of 17" Wh. Oak E. 45.64'

Set tie nail in side of 8" Tw. Oak SE 59.98'

Set tie nail in side of 4" Spruce NW 54.20'

CL St. Sign NE 35.3'

CL Existing Road E. 6'±

Capped Iron E. 33.0'

LCRC Liber 5, Page 60 September 15, 1983

Fd Cast Iron Monument

8" Maple NE 39.61'

St. Sign NE 34.95'

17" Oak E 45.64'

Tw 9" Oak SE 59.98'

18" Pepperridge SE 47.42'

5" Maple NW 61.81'

4" Spruce NW 54.20'