

SURVEY & REMONUMENTATION

APR 24 1995

COMMISSION

OTTAWA COUNTY REMONUMENTATION
LAND CORNER RECORDATION CERTIFICATE
Filing Requirement of Act 74, Mich. P.A. 1970

RECORDED

94 DEC 15 AM 11:49

D. J. ...
REGISTER OF DEEDS
OTTAWA COUNTY, MI

For corners in

<u>Ottawa</u> (County)	Located In: Crockery Twp.	Corner Code # G-7
1. Public Land Survey	T <u>8N</u> R <u>15W</u>	<u>N.E. Corner</u> <u>Section 21</u>
	T ___ R ___	___
	T ___ R ___	___
	T ___ R ___	___
2. Property Controlling in Section	S ___ T ___ R ___	___
	S ___ T ___ R ___	___
3. Miscellaneous Property in Sec.	S ___ T ___ R ___	___
	S ___ T ___ R ___	___
4. Lot No. _____, Recorded Plat _____		
5. Private Claims _____		

Register of Deeds Stamp & File Number

I, Carl P. Englert in a field survey on November 23, 19 94, do hereby certify that under requirements of P.A. 74, Michigan P.A. of 1970, the corner points mentioned in lines 1 and 2 above were in conformance with regulations and rules therefore as required in the current manual of survey instructions of the United States Department of the Interior, Bureau of Land Management or by a decree of a Court of Law and/or that the corner points mentioned in lines 3, 4 and 5 above were in conformance with the rules of the Michigan Board of Land Surveyors or by a Decree of a Court of Law; established, re-established, monumented, re-monumented, recovered, found as expressed below:

	A	B	C	D	E	F	G	H	I	J	K	L	M
2	6	5	4	3	2	1							
3													
4	7	8	9	10	11	12							
5													
6	18	17	16	15	14	13							
7													
8	19	20	21	22	23	24							
9													
10	30	29	28	27	26	25							
11													
12	31	32	33	34	35	36							
13													


NOTE: Not more than 4 corners, all in the same town and range, may be recorded on this certificate.

- A. Description of original monument and accessories and/or subsequent restoration:
 G-7 corner common to Sections 15, 16, 21 & 22
 Original gov't corner set March 1837 by John Mullett
 LCRC Liber 5, Page 60 Sept. 1983
 1" Square Bar in Monument Box
 Gas Warning Pipe NE 56.00'
 Street Sign SE 52.75'
 Set Post S 2.4'
 Hemlock 10" N40°E 12 Links
 Hemlock 10" S82°W 11 Links
 Gas Warning Pipe SW 34.80'
 Stop Sign NW 42.40'
- B. Description of corner evidence found and/or method applied in restoring or reestablishing corner:
 G-7 corner common to Sections 15, 16, 21 & 22
 Found Boat spike in Mon. Box 1'+/- N. of St. E (Boat Spike was in 1 1/2" iron pipe 2' long)
 Found St. Sign SE 53'+/-
 Distance to East 1/4 corner Section 21 checks
 Found Gas Warning Pipe S.W. 34.8'

P.A. 345 OTTAWA COUNTY
PEER APPROVED 12/12/94
Hubert D. Nedewell

Accepted as a careful and faithful perpetuation of the original position of the corner.

- C. Description of monument for corner and accessories established to perpetuate locating the position of the corner:
 G-7 corner common to Sections 15, 16, 21 & 22.
 Set O.C. Remon. Cap on 3/4" x 3' Iron Bar in Mon. Box 6" Deep
 O.C. Remon Tag & Nail in S.E. side P.P. N30°W 64.84'
 O.C. Remon Tag & Nail in S. Side 15" Maple N75°E 142.18'
 O.C. Remon Tag & Nail in W. side 7" Pine S16°W 105.30'
 Top center of Hydrant N30°E 67.85'

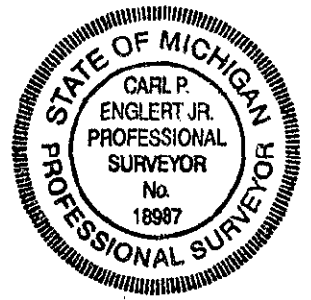

Signed by Carl P. Englert Jr. Date 12/1/94
 Surveyor's Michigan License No. 18987