

# SURVEY & REMONUMENTATION

APR 25 1995

COMMISSION

OTTAWA COUNTY REMONUMENTATION  
LAND CORNER RECORDATION CERTIFICATE  
Filing Requirement of Act 74, Mich. P.A. 1970

RECORDED

94 DEC -8 PM 12:37

*Daphne Robinson*  
REGISTER OF DEEDS  
OTTAWA COUNTY, MI

corners in

<u>Ottawa</u> (County)	Located In: <u>Crockery Twp</u>	Corner Code # <u>G-9</u>
Public Land Survey	T <u>8N</u> R <u>15W</u>	<u>SE Corner</u>
	T _____ R _____	<u>Section 21</u>
	T _____ R _____	_____
	T _____ R _____	_____
Property Controlling in Section	S _____ T _____ R _____	_____
Miscellaneous Property in Sec.	S _____ T _____ R _____	_____

Register of Deeds Stamp & File Number

Lot No. \_\_\_\_\_, Recorded Plat \_\_\_\_\_  
Private Claims \_\_\_\_\_

	A	B	C	D	E	F	G	H	I	J	K	L	M
2	6	5	4	3	2	1							
3													
4	7	8	9	10	11	12							
5													
6	18	17	16	15	14	13							
7													
8	19	20	21	22	23	24							
9													
10	30	29	28	27	26	25							
11													
12	31	32	33	34	35	36							
13													

Carl P. Englert, in a field survey on May 27, 19 94, hereby certify that under requirements of P.A. 74, Michigan P.A. of 1970, the corner points mentioned in lines 1 and 2 above were in conformance with regulations and rules therefore as required in the present manual of survey instructions of the United States Department of the Interior, Bureau of Land Management or by a decree of a Court of Law and/or that the corner points mentioned in lines 3, 4 and 5 above were in conformance with the rules of the Michigan Board of Land Surveyors or by a Decree of a Court of Law; established, re-established, monumented, re-monumented, recovered, found as pressed below:

**NOTE: Not more than 4 corners, all in the same town and range, may be recorded on this certificate.**

Description of original monument and accessories and/or subsequent restoration:  
G-9 corner common to Sections 21, 22, 27 & 28  
Original gov't corner set March, 1837  
by John Mullet D.S.

L.C.R.C. Liber 4, P. 270 (12/4/81)  
Found 1" Iron Bar, Set C.I.M.  
30" Maple W.S.W. 35.22'  
St. Sign N.E. 50.25'  
Tel. Ped. S.E. 46.75'  
Pipeline Marker S.E. 41.70'

Set Post:  
B. Oak 22" N12°W 36 Links  
Do 26" S26°E 36 Links

(See Back of Page)


Description of corner evidence found and/or method applied in restoring or reestablishing corner:  
G-9 corner common to Sections 21, 22, 27 & 28  
Found 4" Harrison Cast Iron Mon. in Mon. Box  
Found 30" Maple W.S.W. 35'+/-

P.A. 345 OTTAWA COUNTY  
PEER APPROVED 11/21/94

*Madison P. Redwood*

Accepted as a careful and faithful perpetuation of the position of the original corner.

Description of monument for corner and accessories established to perpetuate locating the position of the corner:  
G-9 corner common to Sections 21, 22, 27 & 28  
4" Harrison Cast Iron Mon. in Mon. Box  
O.C. Remon. Tag & Nail in S. Side 32" Maple S76°W 34.65'  
O.C. Remon. Tag & Nail in N.E. Side P.P. N22°W 338.80'  
O.C. Remon. Tag & Nail in N. Side P.P. S79°E 279.32'  
O.C. Remon. Tag & Nail in E. Side 35" Oak s9°W 164.29'

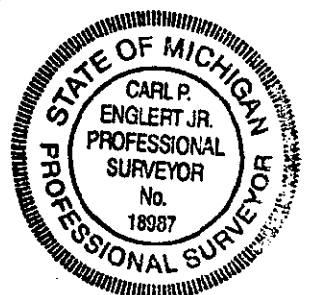

signed by Carl P. Englert  
Surveyor's Michigan License No. 18987

Date 11/21/94

A. Description of original monument and accessories and/or subsequent restoration.

G-9 L.C.R.C. Liber 2, Page 309 (9/13/73)

Found 1" Iron Bar at crossroads

Fence to W. North 10'

30" Maple W.S.W. 33.35'

Centerline St. Sing N.E. 50.22'

Centerline Tel. Junction Box S.E. 46.20'

7001 N  
20000  
0000 N  
1950