

SURVEY & REMONUMENTATION

APR 24 1995

OTTAWA COUNTY REMONUMENTATION LAND CORNER RECORDATION CERTIFICATE

Filing Requirement of Act 74, Mich. P.A. 1970

For corners **COMMISSION**

Politically Robinson Twp.

Ottawa
(County)

Located In: Crockery Twp.
Corner Code #

RECORDED

94 DEC 15 AM 11:52

Doris Kullman
REGISTER OF DEEDS
OTTAWA COUNTY, MI

- | | | | |
|------------------------------------|--------------------------|--------------|--|
| 1. Public Land Survey | T <u>8N</u> R <u>15W</u> | G-12 | |
| | T _____ R _____ | E 1/4 Corner | |
| | T _____ R _____ | Section 33 | |
| | T _____ R _____ | | |
| 2. Property Controlling in Section | S _____ T _____ R _____ | | |
| | S _____ T _____ R _____ | | |
| 3. Miscellaneous Property in Sec. | S _____ T _____ R _____ | | |
| | S _____ T _____ R _____ | | |
4. Lot No. _____, Recorded Plat _____
5. Private Claims _____

Register of Deeds Stamp & File Number

I, Carl P. Englert in a field survey on December 01, 1994, do hereby certify that under requirements of P.A. 74, Michigan P.A. of 1970, the corner points mentioned in lines 1 and 2 above were in conformance with regulations and rules therefore as required in the current manual of survey instructions of the United States Department of the Interior, Bureau of Land Management or by a decree of a Court of Law and/or that the corner points mentioned in lines 3, 4 and 5 above were in conformance with the rules of the Michigan Board of Land Surveyors or by a Decree of a Court of Law; established, re-established, monumented, re-monumented, recovered, found as expressed below:

NOTE: Not more than 4 corners, all in the same town and range, may be recorded on this certificate.

	A	B	C	D	E	F	G	H	I	J	K	L	M
2	6	5	4	3	2	1							
3													
4	7	8	9	10	11	12							
5													
6	18	17	16	15	14	13							
7													
8	19	20	21	22	23	24							
9													
10	30	29	28	27	26	25							
11													
12	31	32	33	34	35	36							
13													

A. Description of original monument and accessories and/or subsequent restoration:

G-12 1/4 corner common to Sections 33 & 34
Original Gov't corner set May 1832
by Calvin Britain D.S.

LCRC Liber 5, Page 57 (6/21/83)
G-12

Set 1/4 mile Post
Alder 3" N31°W 27 Links
Alder 3" S76°E 9 Links

1" Pipe with Plastic Cap
S30°E - 64.85' - Power Pole
N14°W - 120.6' - W. end C.M.P.
N9°E - 260.25' - Power Pole
In line with row of willows to West.

(See Back of Page)

B. Description of corner evidence found and/or method applied in restoring or reestablishing corner:

G-12 corner common to Sections 33 & 34

Found 1" Pipe over Section of Cast Iron Mon. in E Road
Found S30°E 64.85' Power Pole
Found N9°E 260.25' Power Pole (New Pole fd cut off stub)
Found N14°W 120.6' W. end C.M.P.

Accepted as a careful and faithful perpetuation of the original position of the corner.


OTAWA COUNTY
PEER APPROVED 12/12/94

C. Description of monument for corner and accessories established to perpetuate locating the position of the corner:

G-12 1/4 corner common to Sections 33 & 34

Set 3/4" x 2' Iron bar with O.C. Remon. Cap over remains of Cast Iron Mon.
3" deep in E Gravel Road

O.C. Remon. Tag & Nail in S. side 30" Willow	S85°W	52.85'
O.C. Remon. Tag & Nail in S.W. side Power Pole	S29°W	64.81'
O.C. Remon. Tag & Nail in N.W. side 12" Ash	N69°E	52.87'
O.C. Remon. Tag & Nail in W. side Power Pole	N8°E	262.26'

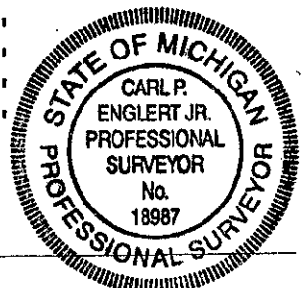

Signed by Carl P. Englert Jr.
Surveyor's Michigan License No. 18987

Date 12/5/94

G-12

Cast Iron Monument

Nail in the Face of 4" Ash	ESE	56.55'
Nail in the Face of Power Pole	SE	58.47'
Nail in the Face of 18" Willow	W	20.55'
Nail in the Face of Triple 18" Willow	SW	20.38'
Nail in the Face of 14" Willow	NW	67.95'