

FEB 24 2000

OTTAWA COUNTY REMONUMENTATION
LAND CORNER RECORDATION CERTIFICATE
Filing Requirement of Act 74, Mich. P.A. 1970

RECORDED
99 SEP 23 PM 3: 21

For corners in

SECTION

Sam Mullett
REGISTER OF DEEDS
OTTAWA COUNTY, MI

<u>Ottawa</u> (County)	Located In:	Corner Code #
	Crockery Township	
1. Public Land Survey	T <u>8N</u> R <u>15W</u>	H-1
	T ___ R ___	<u>N 1/4 corner</u>
	T ___ R ___	<u>Section 3</u>
	T ___ R ___	_____
2. Property Controlling in Section	S ___ T ___ R ___	_____
	S ___ T ___ R ___	_____
3. Miscellaneous Property in Sec.	S ___ T ___ R ___	_____
	S ___ T ___ R ___	_____

Register of Deeds Stamp & File Number

4. Lot No. _____, Recorded Plat _____
5. Private Claims _____

I, Carl P. Englert, in a field survey on 5/27, 1999 do hereby state that under requirements of P.A. 74, Michigan P.A. of 1970, the corner points mentioned in lines 1 and 2 above were in conformance with regulations and rules therefore as required in the current manual of survey instructions of the United States Department of the Interior, Bureau of Land Management or by a decree of a Court of Law and /or that the corner points mentioned in lines 3, 4 and 5 above were in conformance with the rules of the Michigan Board of Land Surveyors or by a Decree of a Court of Law, established, re-established, monumented, recovered, found as expressed below:

NOTE: Not more than 2 corners, all in the same town and range, may be recorded on this certificate.

A	B	C	D	E	F	G	H	I	J	K	L	M
1												
2	6	5	4				3	2	1			
3												
4	7	8	9	10	11	12						
5												
6	18	17	16	15	14	13						
7												
8	19	20	21	22	23	24						
9												
10	30	29	28	27	26	25						
11												
12	31	32	33	34	35	36						
13												

A. Description of original monument and accessories and/or subsequent restoration:

H-1 No corner set, H-13, T9N, R15W Set by John Mullett, 1837, Common to H-1, T8N, R15W Set 1/4 Section Post Hemlock 8" N63°E 11 Links Hemlock 10" S13°W 6 Links	Muskegon County Road Commission Iron 1/2" Rod in Iron Pipe, SW 63.20 Tw. Maple SE 47.70 T. Pole NE 111.60 Tw. Maple No Date
--	--

See Other Side

B. Description of corner evidence found and/or method applied in restoring or reestablishing corner:

H-1 Found 3" Cast Iron Monument in Monument Box 1.3'± South of
Q Asphalt Pavement on Occupation Lines North & South
Found SW 63.20' Tw. Maple
Found NE 111.60' Tw. Maple

Accepted as a careful and faithful perpetuation of the original position of the corner.

C. Description of monument for corner and accessories established to perpetuate locating the position of the corner:

H-1 3" Harrison Cast Iron Monument in Monument Box

O.C. Remon Tag and Nail in S Side 15"	N68°W	79.11'
O.C. Remon Tag and Nail in NW Side 30" Twin Maple	S30°W	63.53'
O.C. Remon Tag and Nail in N Side 30" Maple	S40°E	80.34'
O.C. Remon Tag and Nail in S Side 36" Twin Maple	N76°E	111.51'

8/16/99

Signed by Carl P. Englert
Surveyor's Michigan License No. 18987

Date 8/13/19



Receipt #58324

FEB 24 2000

SECTION


H-1 T8N, R15W
LCRC Liber 2, Page 49 J. Clapp P.S. 14091 Feb. 1973
Found Steel Bar in ϕ Road
Iron S. 33.00'
Fence Post N. 34±

LCRC Liber 2, Page 63 Englert P.S. 18987 Feb. 1973
1/2" Rod
SE 47.90' T.P.
SW 63.52' Tw. Maple
NW 66.92' 8" Apple

LCRC Liber 5, Page 45 Joiner P.S. 18435 May 1983
Found Iron Pipe in Mon. Box Set C.I.M.
12" Tw. Maple SW 63.53'
8" Apple NW 66.96'
Tele. Pole SE 47.89'
Tw. 20" Maple ENE 111.55'

LCRC Liber 1810, Page 36, Muskegon County Remon. Records,
Recorded as H-13, T9N, R15W, by Mr. Vallier, December 1994
Found Cast Iron Mon. in Mon. Box (H-1 Ottawa County, T8N, R15W).
N80°E 11.55' 20" Maple
SE 47.89' T. Pole
S32°W 63.53' 12" Tw. Maple
N20°W 66.96' 8" Apple
N64°W 79.37' Nail N. Side 6" Elm

T9N, R15W
Sec. 34

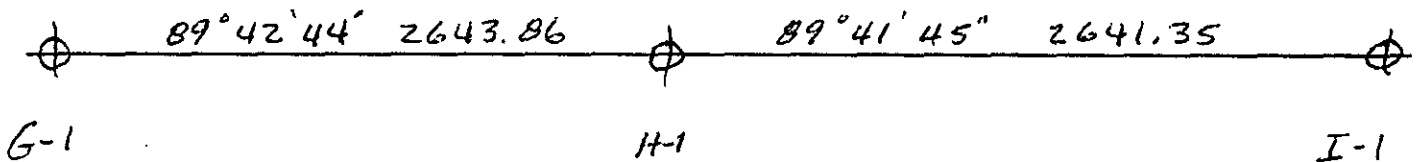

Sec 3
T8N, R15W

