

OTTAWA COUNTY REMONUMENTATION

LAND CORNER RECORDATION CERTIFICATE  
Filing Requirement of Act 74, Mich. P.A. 1970

RECORDED

93 DEC 15 AM 9:32

*D. J. ...*  
REGISTER OF DEEDS  
OTTAWA COUNTY, MI

For corners in

Ottawa  
(County)

Located In: Crockery Township  
Corner Code #

- |                                    |                          |                      |
|------------------------------------|--------------------------|----------------------|
| 1. Public Land Survey              | T <u>8N</u> R <u>15W</u> | <u>H-5</u>           |
|                                    | T _____ R _____          | <u>S. 1/4 Corner</u> |
|                                    | T _____ R _____          | <u>Section 10</u>    |
|                                    | T _____ R _____          | _____                |
| 2. Property Controlling in Section | S _____ T _____ R _____  | _____                |
|                                    | S _____ T _____ R _____  | _____                |
| 3. Miscellaneous Property in Sec.  | S _____ T _____ R _____  | _____                |
|                                    | S _____ T _____ R _____  | _____                |

Register of Deeds Stamp & File Number

4. Lot No. \_\_\_\_\_, Recorded Plat \_\_\_\_\_  
5. Private Claims \_\_\_\_\_

	A	B	C	D	E	F	G	H	I	J	K	L	M
2	6	5	4	3	2	1							
3													
4	7	8	9	10	11	12							
5													
6	18	17	16	15	14	13							
7													
8	19	20	21	22	23	24							
9													
10	30	29	28	27	26	25							
11													
12	31	32	33	34	35	36							
13													

I, Carl P. Englert Jr., in a field survey on August 27, 19 93, do hereby certify that under requirements of P.A. 74, Michigan P.A. of 1970, the corner points mentioned in lines 1 and 2 above were in conformance with regulations and rules therefore as required in the current manual of survey instructions of the United States Department of the Interior, Bureau of Land Management or by a decree of a Court of Law and/or that the corner points mentioned in lines 3, 4 and 5 above were in conformance with the rules of the Michigan Board of Land Surveyors or by a Decree of a Court of Law; established, re-established, monumented, re-monumented, recovered, found as expressed below:

NOTE: Not more than 4 corners, all in the same town and range, may be recorded on this certificate.

A. Description of original monument and accessories and/or subsequent restoration:

- |                                     |                                   |
|-------------------------------------|-----------------------------------|
| H-5                                 | L.C.R.C. Liber 4, Page 69, 6/5/80 |
| L.C.R.C. Liber 1, Page 411, 5/26/72 | Fd. 1" pipe from Ties, Set C.I.M. |
| Fd. Spike                           | T.P. S.E. 64.61'                  |
| P.P. N. 69.10'                      | 7" Pine N.E. 53.51'               |
| T.P. S.E. 64.14'                    | P.P. N. 68.69'                    |
| 8" Cherry Cluster S.W. 122.48'      | 7" Tree S.W. 39.19'               |
| Fence Cor. S. 26.10'                |                                   |

B. Description of corner evidence found and/or method applied in restoring or reestablishing corner:


- |   |                       |
|---|-----------------------|
| H-5   | Found T.P. S.E. 64.5± |
| Found 4" Harrison 6" deep and accepted as a careful and faithful perpetuation of the original position of the corner. | P.P. N. 68.7±         |

C. Description of monument for corner and accessories established to perpetuate locating the position of the corner:

- H-5 4" Harrison cast iron monument
- O.C. Remon. Tag & Nail in S. side 20" Maple N. 80 degrees 174.20'
  - O.C. Remon. Tag & Nail in N.W. side 8' Peppridge 5.48 degrees 56.26'
  - O.C. Remon. Tag & Nail in W. side 12" Peppridge 5.8 degrees West 33.20'
  - O.C. Remon. Tag & Nail in N. side T.P. 566 degrees East 64.48'
  - O.C. Remon. Tag & Nail in E. side 7" Pine N. 15 degrees 52.14' (E.D.M.)

Signed by Carl P. Englert Jr.  
Surveyor's Michigan License No. 18987

Date December 3, 1993

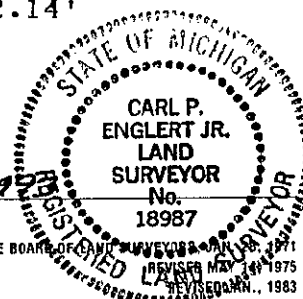

FORM APPROVED BY MICHIGAN STATE BOARD OF LAND SURVEYORS, REVISED MAY 1975