

SURVEY & REMONUMENTATION

APR 05 1996

OTTAWA COUNTY REMONUMENTATION LAND CORNER RECORDATION CERTIFICATE

Filing Requirement of Act 74, Mich. P.A. 1970

For corners in Ottawa
(County)

COMMISSION

Crockery Twp.
Located In:

Corner Code #

1. Public Land Survey	T <u>8</u> N R <u>15</u> W	H - <u>7</u>
	T _____ R _____	<u>S 1/4 Corner</u>
	T _____ R _____	<u>Section 15</u>
	T _____ R _____	_____
2. Property Controlling in Section	S _____ T _____ R _____	_____
	S _____ T _____ R _____	_____
3. Miscellaneous Property in Sec.	S _____ T _____ R _____	_____
	S _____ T _____ R _____	_____

RECORDED

95 NOV 15 PM 2:06

D. J. ...
REGISTER OF DEEDS
OTTAWA COUNTY, MI

Register of Deeds Stamp & File Number

4. Lot No. _____, Recorded Plat _____
5. Private Claims _____

	A	B	C	D	E	F	G	H	I	J	K	L	M
2	6	5	4	3	2	1							
3													
4	7	8	9	10	11	12							
5													
6	18	17	16	15	14	13							
7													
8	19	20	21	22	23	24							
9													
10	30	29	28	27	26	25							
11													
12	31	32	33	34	35	36							
13													

I, Carl P. Englert, Jr., in a field survey on October 8, 1995, do hereby certify that under requirements of P.A. 74, Michigan P.A. of 1970, the corner points mentioned in lines 1 and 2 above were in conformance with regulations and rules therefore as required in the current manual of survey instructions of the United States Department of the Interior, Bureau of Land Management or by a decree of a Court of Law and/or that the corner points mentioned in lines 3, 4 and 5 above were in conformance with the rules of the Michigan Board of Land Surveyors or by a Decree of a Court of Law; established, re-established, monumented, re-monumented, recovered, found as expressed below:

NOTE: Not more than 4 corners, all in the same town and range, may be recorded on this certificate.

A. Description of original monument and accessories and/or subsequent restoration:
 H - 7 1/4 corner common to sections 15 & 22
 Original corner set March 1837 by John Mullett, D.S.
 Set 1/4 Section post
 Beech 12" S 13° W 14 Links
 Beech 22" N 81° E 25 Links
 LCRC Liber 1, Page 549
 June 28, 1972
 Fd. 5/8" Rod in Mon. Box
 NNW 32.48' 16" Maple
 NE 64.32' 24" Maple
 S. 35.64' 6" Aspen
 N. 33.0' R/W Marker

see other side

B. Description of corner evidence found and/or method applied in restoring or reestablishing corner:
 H - 7 1/4 corner common to Sections 15 & 22
 Found 3/4" Re Rod in Mon. Box & Set 2' X 3/4" steel bar with O. C. Remon. Cap
 Found Nail and Tag in West side 18" Maple N. 32.17'
 Found Nail and Tag in NW side 15" Aspen SSE 39.05'
 Found R/W Marker N 33.0'


Accepted as a careful and faithful perpetuation of the position of the original corner.

RA. 345 OTTAWA COUNTY
 PEER APPROVED 10/23/95
Gordon D. Nedwell

C. Description of monument for corner and accessories established to perpetuate locating the position of the corner:
 H - 7 1/4 corner common to Section 15 & 22
 2' Long X 3/4" steel Bar with Ottawa County Remonumentation cap in Mon. Box
 Ottawa County Remonumentation Tag & Nail in NW Side 36" Maple N 58° E 65.08'
 Ottawa County Remonumentation Tag & Nail in W Side 18" Aspen S 11° E 55.76'
 Ottawa County Remonumentation Tag & Nail in NW Side 10" Maple N 67° W 80.36'
 Ottawa County Remonumentation Tag & Nail in S Side 18" Aspen S 67° W 55.76'
 Ottawa County Remonumentation Tag & Nail in W Side 18" Maple N 11° W 32.26'

Signed by Carl P. Englert
 Surveyor's Michigan License No. 18987

Date 10/21/1995

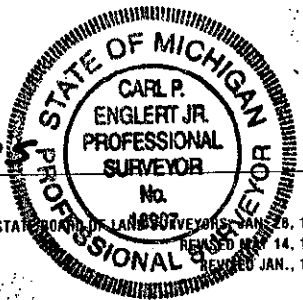

FORM APPROVED BY MICHIGAN STATE BOARD OF LAND SURVEYORS, JAN. 26, 1971
 REVISED MAY 14, 1975
 REVISED JAN., 1983

H-7 T 8 N, R 15 W Crockery Twp.
LCRC Liber 2, Page 725 October 18, 1974
Found Mon. Box 3/4" Rerod inside
12" Maple NNW 31.45'
5" Bigtooth Aspen SSW 35.28'
26" Maple NE 63.65'

LCRC Liber 5, Page 61 September 15, 1983
Fd. 3/4" Steel Bar in Mon Box
30" Maple NE 63.65'
12" Bigtooth Aspen SSW 35.28'
16" Maple NNW 31.45'

LCRC Liber 5, Page 269 March 17, 1987
Fd 3/4" Solid Rod in Mon Box
Nail and Tag in W. side 18" Maple NNW 32.17'
Nail and Tag in N. side 36" Maple ENE 65.10'
Nail and Tag #22445 in W. side 15" Aspen SSE 39.05'

\$ 11.00
CORNER