

SURVEY & REMONUMENTATION

FEB 27 1998

OTTAWA COUNTY REMONUMENTATION
LAND CORNER RECORDATION CERTIFICATE
Filing Requirement of Act 74, Mich. P.A. 1970

SECTION

For corners in

<u>Ottawa</u> <small>(County)</small>	Located in: Crockery Township	Corner Code #	
1. Public Land Survey	T <u>8N</u> R <u>15W</u>	H-9	S 1/4 corner Section 22
	T ___ R ___		
	T ___ R ___		
	T ___ R ___		
2. Property Controlling in Section	S ___ T ___ R ___		
	S ___ T ___ R ___		
3. Miscellaneous Property in Sec.	S ___ T ___ R ___		
	S ___ T ___ R ___		

RECORDED

97 OCT 30 AM 11:00

Debra Gant

Register of Deeds
Ottawa County, MI

Register of Deeds Stamp & File Number

4. Lot No. _____, Recorded Plat _____
5. Private Claims _____

I, Carl P. Englert, in a field survey on 2/28, 1997 do hereby state that under requirements of P.A. 74, Michigan P.A. of 1970, the corner points mentioned in lines 1 and 2 above were in conformance with regulations and rules therefore as required in the current manual of survey instructions of the United States Department of the Interior, Bureau of Land Management or by a decree of a Court of Law and /or that the corner points mentioned in lines 3, 4 and 5 above were in conformance with the rules of the Michigan Board of Land Surveyors or by a Decree of a Court of Law, established, re-established, monumented, recovered, found as expressed below.

NOTE: Not more than 2 corners, all in the same town and range, may be recorded on this certificate.

	A	B	C	D	E	F	G	H	I	J	K	L	M
1													
2	6	5	4	3	2	1							
3													
4	7	8	9	10	11	12							
5													
6	18	17	16	15	14	13							
7													
8	19	20	21	22	23	24							
9													
10	30	29	28	27	26	25							
11													
12	31	32	33	34	35	36							
13													

A. Description of original monument and accessories and/or subsequent restoration:

H-9 1/4 corner common to Sections 22 and 27	LCRC Liber 2, Page 409, 11/30/93
G.L.O. 1837 John Mullett	Found Plow Pt., Crockery & 2" Pipe
Set 1/4 Section Post	S. 61.63' 12" Oak
Pine 24" S82°E 40 links	W. 25.80' 18" Oak
Black Oak 20" S68°W 19 links	N. 44.70' 20" Oak

See Other Side

B. Description of corner evidence found and/or method applied in restoring or reestablishing corner:

H-9 1/4 corner common to Sections 22 and 27
Found 4" Harrison Cast Iron Monument
Found 10" Oak SE 18.65'
Found 12" Oak ENE 22.69'
Found 9" Oak West 15.20'
Found Fence Line West

P.A. 345 OTTAWA COUNTY
PEER APPROVED 9-15-97


YD7

Accepted as a careful and faithful perpetuation of the original position of the corner.

C. Description of monument for corner and accessories established to perpetuate locating the position of the corner:

H-9 1/4 corner common to Sections 22 and 27	
4" Harrison Cast Iron Monument at grade	
O.C. Remon Tag & Nail in SE Side 17" Oak	N74°E 22.82'
O.C. Remon Tag & Nail in NE Side 9" Maple	S37°E 22.61'
O.C. Remon Tag & Nail in NE Side 14" Oak	N54°W 25.28'
O.C. Remon Tag & Nail in E Side 18" Oak	N 4°W 44.72'

\$ 11.00 CORNER
\$ 2.00

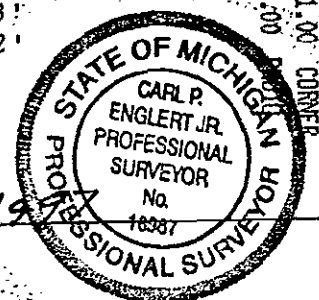

Signed by Carl P. Englert Jr.
Surveyor's Michigan License No. 018987

Date 9/25/1997

Town 8 North, Range 15 West
LCRC Liber 4, Page 261 12/4/1981
Found Iron Pipe Set Cast Iron Monument
10" Oak SE 18.65'
12" Oak ENE 22.69'
9" Oak West 15.20'
8" Oak NW 21.60'

SURVEY &
REMONUMENTATION

FEB 27 1998

SECTION