

SURVEY & REMONUMENTATION

**OTTAWA COUNTY REMONUMENTATION
LAND CORNER RECORDATION CERTIFICATE
Filing Requirement of Act 74, Mich. P.A. 1970**

RECORDED
94 DEC 15 AM 11:52

APR 24 1995

For corners in
COMMISSION
Ottawa
(County)

Located In: **Crockery Twp.** Corner Code #

- | | | |
|------------------------------------|--------------------------|---------------------|
| 1. Public Land Survey | T <u>8N</u> R <u>15W</u> | <u>H-11</u> |
| | T _____ R _____ | <u>N 1/4 Corner</u> |
| | T _____ R _____ | <u>Section 34</u> |
| | T _____ R _____ | _____ |
| 2. Property Controlling in Section | S _____ T _____ R _____ | _____ |
| | S _____ T _____ R _____ | _____ |
| 3. Miscellaneous Property in Sec. | S _____ T _____ R _____ | _____ |
| | S _____ T _____ R _____ | _____ |

Dorothy R. Edelman
REGISTER OF DEEDS
OTTAWA COUNTY, MI

Register of Deeds Stamp & File Number

4. Lot No. _____, Recorded Plat _____
5. Private Claims _____

	A	B	C	D	E	F	G	H	I	J	K	L	M
2	6	5	4	3	2	1							
3													
4	7	8	9	10	11	12							
5													
6	18	17	16	15	14	13							
7													
8	19	20	21	22	23	24							
9													
10	30	29	28	27	26	25							
11													
12	31	32	33	34	35	36							
13													

I, Carl P. Englert in a field survey on December 07, 19 94, do hereby certify that under requirements of P.A. 74, Michigan P.A. of 1970, the corner points mentioned in lines 1 and 2 above were in conformance with regulations and rules therefore as required in the current manual of survey instructions of the United States Department of the Interior, Bureau of Land Management or by a decree of a Court of Law and/or that the corner points mentioned in lines 3, 4 and 5 above were in conformance with the rules of the Michigan Board of Land Surveyors or by a Decree of a Court of Law; established, re-established, monumented, re-monumented, recovered, found as expressed below:

NOTE: Not more than 4 corners, all in the same town and range, may be recorded on this certificate.

A. Description of original monument and accessories and/or subsequent restoration:

H-11 1/4 corner common to Sections 27 & 34
Original Gov't corner set March, 1837 by John Mullet D.S. LCRC Liber 5, Page 172 (12/14/84)
SET CIM
6" Pine S 16.46
15" Oak SW 13.50
13" Oak SE 6.00
8" Oak NW 17.67

(See Back of Page)

B. Description of corner evidence found and/or method applied in restoring or reestablishing corner:

H-11 1/4 corner common to Sections 27 & 34
Found 4" Conc. Mon. with Aluminum Cap Marked DNR Sec. 27 & 34
D.L.B. 186.55 6" Above Ground
Found 14" Oak S58°W 13.51'
Found 6" W. Pine S14°W 16.48'
Found 14" Oak S30°E 5.97'
Found 7" Oak N42°W 17.63'

P.A. 345 OTTAWA COUNTY
FEER APPROVED 12/12/94
Wendy D. Hester


Accepted as a careful and faithful perpetuation of the original position of the corner.

C. Description of monument for corner and accessories established to perpetuate locating the position of the corner:

H-11 1/4 corner common to Sections 27 & 34
4" Conc. Mon. with Aluminum Cap Marked DNR Sec. 27 & 34 D.L.B 186.55
O.C. Remon. Tag & Nail in N.E. side 10" Oak N30°W 19.57'
O.C. Remon. Tag & Nail in E. side 6" Wh. Pine S14°W 16.44'
O.C. Remon. Tag & Nail in N.E. side 14" Oak S30°E 6.02'
O.C. Remon. Tag & Nail in S.E. side 14" Oak S58°W 13.48'

Signed by Carl P. Englert
Surveyor's Michigan License No. 18987

Date 12/11/94

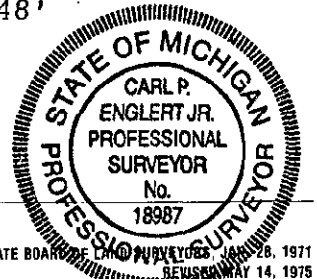

FORM APPROVED BY MICHIGAN STATE BOARD OF LAND SURVEYORS, JAN 28, 1971
REVISED MAY 14, 1975
REVISED JAN., 1983

LCRC Liber 5, Page 58 (6/21/83)

H-11

4" x 36" Conc. Mon. with alum. Cap

S58°W - 13.51' - 14" W. Oak

S14°W - 16.48' - 4" W. Pine

S30°E - 5.97' - 14" B. Oak

N42°W - 17.63' - 7" W. Oak

1983
JUN 21
11 11