

SURVEY & REMONUMENTATION

JUN 28 1999

OTTAWA COUNTY REMONUMENTATION
LAND CORNER RECORDATION CERTIFICATE
 Filing Requirement of Act 74, Mich. P.A. 1970

98 NOV 11 PM 1:26

Jan Schultz
 REGISTER OF DEEDS
 OTTAWA COUNTY, MI

For corners in SECTION Robinson Twp.

Ottawa (County)	Located In:	Corner Code #
1. Public Land Survey	T <u>8N</u> R <u>15W</u>	H-13
	T <u> </u> R <u> </u>	South 1/4 corner
	T <u> </u> R <u> </u>	Section 34
	T <u> </u> R <u> </u>	_____
2. Property Controlling In Section	S <u> </u> T <u> </u> R <u> </u>	_____
	S <u> </u> T <u> </u> R <u> </u>	_____
3. Miscellaneous Property in Sec.	S <u> </u> T <u> </u> R <u> </u>	_____
	S <u> </u> T <u> </u> R <u> </u>	_____

Register of Deeds Stamp & File Number

4. Lot No. _____, Recorded Plat _____
 5. Private Claims _____

	A	B	C	D	E	F	G	H	I	J	K	L	M
1													
2	6		5		4		3		2		1		
3													
4	7		8		9		10		11		12		
5													
6	18		17		16		15		14		13		
7													
8	19		20		21		22		23		24		
9													
10	30		29		28		27		26		25		
11													
12	31		32		33		34		35		36		
13													

I, Carl P. Englert, Jr., in a field survey on 10/16, 19 98 do hereby state that under requirements of P.A. 74, Michigan P.A. of 1970, the corner points mentioned in lines 1 and 2 above were in conformance with regulations and rules therefore as required in the current manual of survey instructions of the United States Department of the Interior, Bureau of Land Management or by a decree of a Court of Law and /or that the corner points mentioned in lines 3, 4 and 5 above were in conformance with the rules of the Michigan Board of Land Surveyors or by a Decree of a Court of Law, established, re-established, monumented, recovered, found as expressed below:

NOTE: Not more than 2 corners, all in the same town and range, may be recorded on this certificate.

A. Description of original monument and accessories and/or subsequent restoration:

H-13 South 1/4 corner Section 34, T8N, R15W	L.C.R.C. Liber 3, Page 174
G.L.O. 1832 by Calvin Britain	Found 2" Pipe
Set 1/2 mile Post	28" R. Oak S 65° E 87.54'
White Oak 10" N 33° W 19 Links	16" Pin Oak S 40° W 6.12'
White Oak 7" N 44° E 26 Links	16" Pin Oak S 40° W 37.00'
E.H. Peck March 1899 Set Stake	12" Black Ash N 22° W 48.61'
	Cambell June, 1977

See Other Side

B. Description of corner evidence found and/or method applied in restoring or reestablishing corner:


H-13 Found a 2" Wellpoint on South Side of 2 track trail running E & W on E & W Fence Line Found Concrete Monument called for in Liber 3, Page 174 and Liber 5, Page 57 25.08 feet North of 2" pipe, and did not use in this survey.
 < For "pipe" read "wellpoint"

Accepted the 2" Wellpoint as a careful and faithful perpetuation of the original position of the corner.

DAVID S. OTTAWA COUNTY
 PEER APPROVED 10/19/98

C. Description of monument for corner and accessories established to perpetuate locating the position of the corner:

H-13 South 1/4 corner Section 34, T8N, R15W
 Set 3/4 x 36" Iron Bar with O.C. Remon Cap in place of 2" Wellpoint 4" below grade
 O.C. Remon Tag & Nail in W Side 9" Triple Oak N 35° E 47.62'
 O.C. Remon Tag & Nail in SW Side 8" Oak N 30° W 31.73'
 O.C. Remon Tag & Nail in N Side 13" Oak S 78° W 51.60
 O.C. Remon Tag & Nail in NE Side 7" Maple S 50° E 21.83
 N 1/4 Cor. Sec 3, T7N, R15W East 26.40'

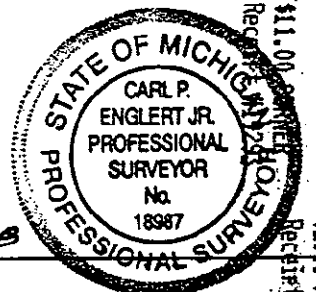

Signed by Carl P. Englert Jr.
 Surveyor's Michigan License No. 18987

Date 10/17/1998

SURVEY &
REMONUMENTATION

JUN 28 1999

SECTION

H-13 Section 34, T8N, R15W
L.C.R.C. Liber 5, Page 57 Donald Bissell 1983
Found 2" pipe with Witnesses from Courthouse
Replaced with 4"x36" Con. Mon. with Aluminum Cap
S 40° W 37.08' 12" Oak
N 22° W 48.71' 7" Ash
S 40° W 6.18' 14" Oak
East 50.08' 4" W. Pine
S 31° E 47.45' 8" W. Oak
Holland Eng. Survey Notes (no date)
Show 2" pipe 25 feet South of Bissell corner

