

**SURVEY &  
REMONUMENTATION**

**FEB 27 1998**

OTTAWA COUNTY REMONUMENTATION  
LAND CORNER RECORDATION CERTIFICATE  
Filing Requirement of Act 74, Mich. P.A. 1970

For corners in **SECTION**

<u>Ottawa</u> (County)	Located in: Crockery Township	Corner Code # I-2
1. Public Land Survey	T 8N R 15W	W 1/4 corner Section 2
2. Property Controlling in Section	S T R	
3. Miscellaneous Property in Sec.	S T R	

**RECORDED**

97 OCT 30 AM 11:01

*Debra Gant*

Register of Deeds  
Ottawa County, MI

Register of Deeds Stamp & File Number

4. Lot No. \_\_\_\_\_, Recorded Plat \_\_\_\_\_  
5. Private Claims \_\_\_\_\_

I, Carl P. Englert, in a field survey on 3/31, 1997 do hereby state that under requirements of P.A. 74, Michigan P.A. of 1970, the corner points mentioned in lines 1 and 2 above were in conformance with regulations and rules therefore as required in the current manual of survey instructions of the United States Department of the Interior, Bureau of Land Management or by a decree of a Court of Law and/or that the corner points mentioned in lines 3, 4 and 5 above were in conformance with the rules of the Michigan Board of Land Surveyors or by a Decree of a Court of Law, established, re-established, monumented, recovered, found as expressed below.

NOTE: Not more than 2 corners, all in the same town and range, may be recorded on this certificate.

1	A	B	C	D	E	F	G	H	I	J	K	L	M
2		6		5		4		3	⊙	2		1	
3													
4		7		8		9		10		11		12	
5													
6		18		17		16		15		14		13	
7													
8		19		20		21		22		23		24	
9													
10		30		29		28		27		26		25	
11													
12		31		32		33		34		35		36	
13													

A. Description of original monument and accessories and/or subsequent restoration:

I-2 1/4 corner common to Section 2 and 3  
G.L.O. 1837 John Mullet LCRC Liber 2, Page 5 1/23/1973  
Set 1/4 Section Post Could not find stone  
Beech 9" S26°W 40 links Set R.R. spike on line between  
Hemlock N09°E 25 links section corners and on fence lines E & W  
SE 44.40 10" Ash  
E 35.55 T.P.  
NW 59.24 T.P.  
WSW 44.78 7" Maple

See Other Side

B. Description of corner evidence found and/or method applied in restoring or reestablishing corner:

I-2 1/4 corner common to Sections 2 and 3  
Found 3" Harrison Cast Iron Monument in Monument Box  
Found stub of Tele.Pole East 35.6± (No Nail)  
Found stump of an Ash Tree SE 44.5± (No Nail)  
Found 14" Maple WSW 44.5± (No Nail)  
0.5± East of Road centerline on Fence line East

PA. 345 OTTAWA COUNTY  
PEER APPROVED 9-15-97


Accepted as a careful and faithful perpetuation of the original position of the corner.

C. Description of monument for corner and accessories established to perpetuate locating the position of the corner:

I-2 1/4 corner common to Sections 2 and 3  
3" Harrison Cast Iron Monument in Monument Box  
O.C. Remon Tag & Nail in S. Side Power Pole N80°W 113.04'  
O.C. Remon Tag & Nail in N. Side 14" Maple S77°W 43.85'  
O.C. Remon Tag & Nail in SW. Side 3" Ash N40°W 42.20'  
O.C. Remon Tag & Nail in NW. Side 5" Maple N48°E 52.16'  
O.C. Remon Tag & Nail in N. Side Power Pole East 31.52'

Signed by Carl P. Englert Jr.  
Surveyor's Michigan License No. 18987

Date 9/15/1997

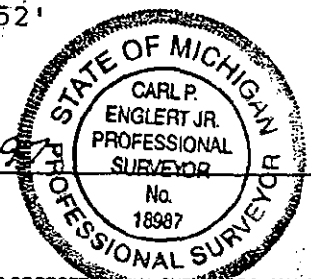

I-2 Town 8 North, Range 15 West  
LCRC Liber 2, Page 59  
Same as Liber 2 pages

LCRC Liber 5, Page 47  
Found R.R. Spike in Mon. Box  
Set CIM  
Tele. Pole NW 59.25'  
Tele. Pole E 35.58'  
11" Ash SE 44.40'  
4" Maple WSW 44.42'

**SURVEY &  
REMONUMENTATION**

FEB 27 1998

SECTION