

RECORD

1007

OTTAWA COUNTY REMONUMENTATION

RECORDED

COLLIER

LAND CORNER RECORDATION CERTIFICATE

93 DEC 15 AM 9:31

Filing Requirement of Act 74, Mich. P.A. 1970

For corners in

<u>Ottawa</u> (County)	Located In:	Corner Code #
	<u>Crockery Township</u>	
1. Public Land Survey	T <u>8N</u> R <u>15W</u>	<u>I-4</u>
	T _____ R _____	<u>E 1/4 Corner</u>
	T _____ R _____	<u>Section 10</u>
	T _____ R _____	_____
2. Property Controlling in Section	S _____ T _____ R _____	_____
	S _____ T _____ R _____	_____
3. Miscellaneous Property in Sec.	S _____ T _____ R _____	_____
	S _____ T _____ R _____	_____

Phyllis Kellerman
REGISTER OF DEEDS
OTTAWA COUNTY, MI

Register of Deeds Stamp & File Number

- 4. Lot No. _____, Recorded Plat _____
- 5. Private Claims _____

Carl P. Englert Jr.

I, _____, in a field survey on August 30, 19 93, do hereby certify that under requirements of P.A. 74, Michigan P.A. of 1970, the corner points mentioned in lines 1 and 2 above were in conformance with regulations and rules therefore as required in the current manual of survey instructions of the United States Department of the Interior, Bureau of Land Management or by a decree of a Court of Law and/or that the corner points mentioned in lines 3, 4 and 5 above were in conformance with the rules of the Michigan Board of Land Surveyors or by a Decree of a Court of Law; established, re-established, monumented, re-monumented, recovered, found as expressed below:

A	B	C	D	E	F	G	H	I	J	K	L	M
2	6	5	4	3	2							
3												
4	7	8	9	10	11	12						
5												
6	18	17	16	15	14	13						
7												
8	19	20	21	22	23	24						
9												
10	30	29	28	27	26	25						
11												
12	31	32	33	34	35	36						
13												

NOTE: Not more than 4 corners, all in the same town and range, may be recorded on this certificate.

A. Description of original monument and accessories and/or subsequent restoration:

- I-4
- L.C.R.C., Liber 1, Page 581 (8-21-1972)
- Fd. Mon. Box & "T" Iron P.P., NE 98.91'
- P.P., SW 97.18'
- T.P., SE 95.48'
- L.C.R.C., Liber 5, Page 91, (12-20-1983)
- Fd. "T" Iron, Mon. Box, Set C.I.M.
- T.P., Se 95.65'
- P.P., SW 97.68'
- P.P., NE 99.31'
- Iron bar, W 33.00'

B. Description of corner evidence found and/or method applied in restoring or reestablishing corner:

- I-4
- Found broken 3" Harrison Mon. in Mon. box and accepted as a careful and faithful perpetuation of the position of the original corner.
- T.P., SE 95.65'
- P.P., NE 99.31'
- Iron Bar, 33.00' West


C. Description of monument for corner and accessories established to perpetuate locating the position of the corner:

- I-4 Set O.C. Remon. Cap over 3" Harrison Mon. in Mon. Box
- O.C. Remon. Tag & Nail in W side 28" Maple, N 11 degrees E 179.44'
- O.C. Remon. Tag & Nail in SE side P.P., N 60 degrees E 99.21'
- O.C. Remon. Tag & Nail in N side P.P., S 86 degrees E 160.98'
- O.C. Remon. Tag & Nail in NE side P.P., S 21 degrees E 95.66'
- O.C. Remon. Tag & Nail in NW side P.P., S 22 degrees W 91.85'

(E.D.M.)

Signed by Carl P. Englert Jr.
Surveyor's Michigan License No. 18987

Date December 3, 1993

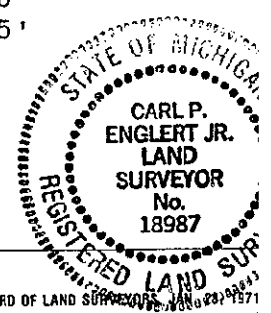

FORM APPROVED BY MICHIGAN STATE BOARD OF LAND SURVEYORS, JAN 29, 1971
REVISED MAY 14, 1975
REVISED JAN., 1983