

**SURVEY &
REMONUMENTATION**

APR 05 1996

**OTTAWA COUNTY REMONUMENTATION
LAND CORNER RECORDATION CERTIFICATE
Filing Requirement of Act 74, Mich. P.A. 1970**

RECORDED

For corners in **COMMISSION**

95 NOV 15 PM 2:07

Phyllis Kullman
REGISTER OF DEEDS
OTTAWA COUNTY, MI

Register of Deeds Stamp & File Number

<u>Ottawa</u> (County)	Located In: Crockery Twp.	Corner Code # I - 6
1. Public Land Survey	T 8 N R 15 W	E. 1/4 corner Section 15
	T ___ R ___	
	T ___ R ___	
	T ___ R ___	
2. Property Controlling in Section	S ___ T ___ R ___	
	S ___ T ___ R ___	
3. Miscellaneous Property in Sec.	S ___ T ___ R ___	
	S ___ T ___ R ___	
4. Lot No. _____, Recorded Plat _____		
5. Private Claims _____		

	A	B	C	D	E	F	G	H	I	J	K	L	M
2	6	5	4	3	2	1							
3													
4	7	8	9	10	11	12							
5													
6	18	17	16	15	14	13							
7													
8	19	20	21	22	23	24							
9													
10	30	29	28	27	26	25							
11													
12	31	32	33	34	35	36							
13													

I, Carl P. Englert, Jr., in a field survey on October 16, 19 95, do hereby certify that under requirements of P.A. 74, Michigan P.A. of 1970, the corner points mentioned in lines 1 and 2 above were in conformance with regulations and rules therefore as required in the current manual of survey instructions of the United States Department of the Interior, Bureau of Land Management or by a decree of a Court of Law and/or that the corner points mentioned in lines 3, 4 and 5 above were in conformance with the rules of the Michigan Board of Land Surveyors or by a Decree of a Court of Law; established, re-established, monumented, re-monumented, recovered, found as expressed below:

NOTE: Not more than 4 corners, all in the same town and range, may be recorded on this certificate.

- A. Description of original monument and accessories and/or subsequent restoration:
- | | |
|---|------------------------|
| I-6 1/4 corner common to Sections 14 & 15 | LCRC Liber 2, Page 407 |
| Original Corner set March, 1837 | November 29, 1973 |
| by John Mullett, D.S. | Found Boat Spike |
| Hemlock 6" S 10° W 02 Links | NE to F.P. 45.55' |
| Hemlock 8" N 22° E 13 Links | SW P.P. 46.15' |
| | NW 4" Tree 50.23' |

see other side

- B. Description of corner evidence found and/or method applied in restoring or reestablishing corner:

I-6 1/4 corner common to Sections 14 & 15
 Found 4" CIM in Mon Box
 Found Stump WNW 49.5'±
 Found P.P. SW 46.49'
 Found T.P. ENE 57.72
 Found Fence Post NE 45.55'± (leaning)

P.A. 345 OTTAWA COUNTY
 PEER APPROVED 10/23/95

Don Hedger P. Hedger


Accepted as a careful and faithful perpetuation of the original position of the corner.

- C. Description of monument for corner and accessories established to perpetuate locating the position of the corner:

I-6 1/4 corner Common to Sections 14 & 15
 4" CIM in Mon Box in CL asphalt Pavement
 Ottawa County Remonumentation Nail and Tag in Quad Maple N 36° W 79.91'
 Ottawa County Remonumentation Nail and Tag in SE side P.P. S 37° W 46.54'
 Ottawa County Remonumentation Nail and Tag in S Side Service Pole N 73° E 57.95'
 Ottawa County Remonumentation Nail and Tag in SE side Twin 8" Maple N 19° E 96.56'
 Top Center of Fire Hydrant N 55° E 35.08'

Signed by Carl P. Englert Jr.
 Surveyor's Michigan License No. 18987

Date 10/17/1995

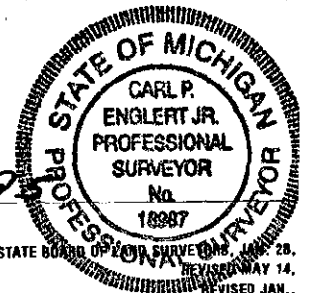

FORM APPROVED BY MICHIGAN STATE BOARD OF PROFESSIONAL SURVEYORS, REVISED MAY 14, 1987, REVISED JAN. 1995

LCRC Liber 5, Page 62
Sept 15, 1983
Found Boat spike in Mon Box
Fence Post NE 45.55'
Service Pole ENE 57.72'
P.P. SW 46.20'
12" Elm NW 50.23'

LCRC Liber 5, Page 269
March 17, 1987
Found Boat Spike in Mon. Box
Face 12" Elm WNW 49.5'
Nail in N. side Service Pole SW 57.75'
Nail in NW side P.P. SW 46.20
Nail in NW side F.P. NE 45.48'

LCRC Liber 6, Page 29
December 26, 1989
Fd. Boat Spike in Mon. Box, Set CIM
P.P. SW 46.49'
16" Elm WNW 50.22'
SW Corner Porch SE 102.10
T.P. ENE 57.72'

\$ 11.00 CORNER