

**SURVEY & REMONUMENTATION**

APR 05 1996

**COMMISSION**

**OTTAWA COUNTY REMONUMENTATION  
LAND CORNER RECORDATION CERTIFICATE  
Filing Requirement of Act 74, Mich. P.A. 1970**

For corners in

Ottawa (County)	Crockery Twp. Located In:	Corner Code #
1. Public Land Survey	T <u>8N</u> R <u>15W</u>	<u>I-7</u>
	T _____ R _____	<u>SE Corner</u>
	T _____ R _____	<u>Section 15</u>
	T _____ R _____	_____
2. Property Controlling in Section	S _____ T _____ R _____	_____
	S _____ T _____ R _____	_____
3. Miscellaneous Property in Sec.	S _____ T _____ R _____	_____
	S _____ T _____ R _____	_____
4. Lot No. _____, Recorded Plat _____		
5. Private Claims _____		

**RECORDED**

95 NOV 15 PM 2:06

*Elizabeth Kallman*  
REGISTER OF DEEDS  
OTTAWA COUNTY, MI

Register of Deeds Stamp & File Number

I, Carl P. Englert, Jr., in a field survey on October 8<sup>th</sup>, 19 95, do hereby certify that under requirements of P.A. 74, Michigan P.A. of 1970, the corner points mentioned in lines 1 and 2 above were in conformance with regulations and rules therefore as required in the current manual of survey instructions of the United States Department of the Interior, Bureau of Land Management or by a decree of a Court of Law and/or that the corner points mentioned in lines 3, 4 and 5 above were in conformance with the rules of the Michigan Board of Land Surveyors or by a Decree of a Court of Law; established, re-established, monumented, re-monumented, recovered, found as expressed below:

	A	B	C	D	E	F	G	H	I	J	K	L	M
2	6	5	4	3	2	1							
3													
4	7	8	9	10	11	12							
5													
6	18	17	16	15	14	13							
7													
8	19	20	21	22	23	24							
9													
10	30	29	28	27	26	25							
11													
12	31	32	33	34	35	36							
13													

**NOTE: Not more than 4 corners, all in the same town and range, may be recorded on this certificate.**

**A. Description of original monument and accessories and/or subsequent restoration:**

I-7 Corner common to Sections 14, 15, 22, & 23  
Set March, 1837 by John Mullet D. S.  
Set Post

L.C.R.C. Liber 1, Page 549  
July 31, 1972  
Fd. 3/4" Pipe SE 28.61' P.P.  
East 34.93' 7" Spruce  
NE 83.5' Guy Pole

see other side

**B. Description of corner evidence found and/or method applied in restoring or reestablishing corner:**

I-7 Corner common to Sections 14, 15, 22, & 23  
Found 4" C.I.M. 1.0' Deep  
Found Nail and Tag in W. Side P.P. ENE 67.91'  
Found Nail and Tag in S. Side 12" Spruce E. 34.93'  
Found 16" Maple S.W. (no nail) SW 97.2± to CL

PA. 345 OTTAWA COUNTY  
PEER APPROVED 10/23/95

*Bradley D. Newell*  
*BDN*


Accepted as a careful and faithful perpetuation of the position of the original corner.

**C. Description of monument for corner and accessories established to perpetuate locating the position of the corner:**

I-7 4" CIM 1.0' deep (Placed monument box) Set 6" X 3/4" Bar with Remon. Cap over CIM  
Ottawa County Remonumentation Tag and Nail in NW side P.P. N 52°E 24.78'  
Ottawa County Remonumentation Tag and Nail in W side 12" Spruce N.84°E 34.95'  
Ottawa County Remonumentation Tag and Nail in W side Guy Pole N24°E 67.88'  
Ottawa County Remonumentation Tag and Nail in SW side T.P. N38°W 75.80'  
Ottawa County Remonumentation Tag and Nail in SE side 16" Maple S54°W 97.14'  
Corner 5.5'± West of E. Edge of asphalt on CL of M-104 West.

Signed by Carl P. Englert Jr.  
Surveyor's Michigan License No. 18987

Date 10/18/1995

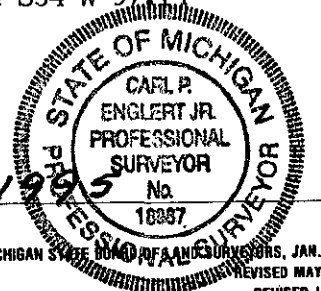

FORM APPROVED BY MICHIGAN STATE BOARD OF LAND SURVEYORS, JAN. 28, 1971  
REVISED MAY 14, 1975  
REVISED JAN., 1983

LCRC Liber 4, Page 68  
June 5, 1980  
Fd 3/4" Pipe - set CIM.  
P.P. SE 28.61'  
7" Spruce E. 34.93'  
P.K. in Guy Pole NE 83.71'  
Nail in Light Support Pole NW 85.25

LCRC Liber 5, Page 62  
September 22, 1983  
Fd. 3/4" Iron Pipe  
Guy Pole NE 83.71'  
12" Spruce E. 34.93'  
P.P. SE 28.61'

LCRC Liber 5, Page 269  
March 18, 1987  
Fd CIM  
Nail and Tag #22445 in W. side Guy Pole ENE 67.91'  
Nail and Tag in S. side 12" Spruce E 34.93'  
Nail and Tag in SE side 12" Maple SW 97.23'

\$ 11.00 CORNER