

**SURVEY &
REMONUMENTATION**

APR 05 1996

COMMISSION OTTAWA COUNTY REMONUMENTATION
LAND CORNER RECORDATION CERTIFICATE
Filing Requirement of Act 74, Mich. P.A. 1970

RECORDED

95 DEC 12 PM 4: 53

Phyllis Robinson
REGISTER OF DEEDS
OTTAWA COUNTY, MI

For corners in

Crockery

<u>Ottawa</u> <small>(County)</small>	Located In:	Corner Code <u>##</u>
1. Public Land Survey	T <u>8 N</u> R <u>15 W</u>	<u>I - 9</u>
	T _____ R _____	<u>SW Corner</u>
	T _____ R _____	<u>Section 23</u>
	T _____ R _____	_____
2. Property Controlling in Section	S _____ T _____ R _____	_____
	S _____ T _____ R _____	_____
3. Miscellaneous Property in Sec.	S _____ T _____ R _____	_____
	S _____ T _____ R _____	_____

Register of Deeds Stamp & File Number

4. Lot No. _____, Recorded Plat _____
5. Private Claims _____

	A	B	C	D	E	F	G	H	I	J	K	L	M
2	6		5		4		3		2		1		
3													
4	7		8		9		10		11		12		
5													
6	18		17		16		15		14		13		
7													
8	19		20		21		22		23		24		
9													
10	30		29		28		27		26		25		
11													
12	31		32		33		34		35		36		
13													

I, Carl P. Englert, Jr., in a field survey on October 19, 19 95, do hereby certify that under requirements of P.A. 74, Michigan P.A. of 1970, the corner points mentioned in lines 1 and 2 above were in conformance with regulations and rules therefore as required in the current manual of survey instructions of the United States Department of the Interior, Bureau of Land Management or by a decree of a Court of Law and/or that the corner points mentioned in lines 3, 4 and 5 above were in conformance with the rules of the Michigan Board of Land Surveyors or by a Decree of a Court of Law; established, re-established, monumented, re-monumented, recovered, found as expressed below:

NOTE: Not more than 4 corners, all in the same town and range, may be recorded on this certificate.

A. Description of original monument and accessories and/or subsequent restoration:

I - 9 Corner common to Sections 22, 23, 26, & 27.
Original corner Set March 1832
by John Mullett, D.S.
Set Post
Sugar 22" N 89½° E 9.68 chains
Beech 13" S 89° E 9.65 chains

PA. 345 OTTAWA COUNTY
PEER APPROVED 12/11/95
Wesley D. Maden
WDM

B. Description of corner evidence found and/or method applied in restoring or reestablishing corner:

I - 9 Corner common to Sections 22, 23, 26 & 27
Set 3' Long 3/4" Iron Bar with Ottawa County Remonumentation Cap by extending line 1335.10 feet South on line with an angle Iron set in a survey #2756 (T K A) by Jack Clapp, June 23, 1967 and the ¼ corner common to Sections 22 & 23.

see other side


Accepted as a careful and faithful perpetuation of the position of the original corner.

C. Description of monument for corner and accessories established to perpetuate locating the position of the corner:

I - 9 Corner common to Sections 22, 23, 26 & 27.
3' long 3/4" Steel bar with Ottawa County Remonumentation Cap
Ottawa County Remonumentation Tag and Nail in S. side 16" Willow N 55° W 44.88'
Ottawa County Remonumentation Tag and Nail in S. side 8" Tw Maple N 76° W 54.62'
Ottawa County Remonumentation Tag and Nail in E. side 6" Ash N 26° W 60.48'
Ottawa County Remonumentation Tag and Nail in W. side 8" Maple N 13° W 75.85'

Corner is 40± into Blackbrush Swamp to East.

Signed by Carl P. Englert Jr.
Surveyor's Michigan License No. 18987

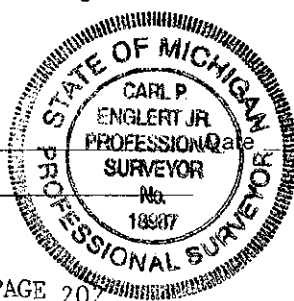

10/23/1995

FORM APPROVED BY MICHIGAN STATE BOARD OF LAND SURVEYORS, JAN. 28, 1971
REVISED MAY 14, 1975
REVISED JAN., 1983

