

RECORDED

OTTAWA COUNTY REMONUMENTATION
LAND CORNER RECORDATION CERTIFICATE
Filing Requirement of Act 74, Mich. P.A. 1970

DEC 18 PM 4:54

Richard R. Robinson
REGISTER OF DEEDS
OTTAWA COUNTY, MI

For corners in

<u>Ottawa</u> (County)	Located in:	Corner Code #
	Crockery Township	
1. Public Land Survey	T <u>8N</u> R <u>15W</u>	<u>I-10</u>
	T ___ R ___	<u>East 1/4 Corner</u>
	T ___ R ___	<u>Section 27</u>
	T ___ R ___	_____
2. Property Controlling in Section	S ___ T ___ R ___	_____
	S ___ T ___ R ___	_____
3. Miscellaneous Property in Sec.	S ___ T ___ R ___	_____
	S ___ T ___ R ___	_____
4. Lot No. _____, Recorded Plat _____		
5. Private Claims _____		

Register of Deeds Stamp & File Number

1	A	B	C	D	E	F	G	H	I	J	K	L	M
2		6		5		4		3		2		1	
3													
4		7		8		9		10		11		12	
5													
6		10		17		16		15		14		13	
7													
8		19		20		21		22		23		24	
9													
10		30		29		28		27		26		25	
11													
12		31		32		33		34		35		36	
13													

I, Carl P. Englert, in a field survey on 9/16, 1996 do hereby state that under requirements of P.A. 74, Michigan P.A. of 1970, the corner points mentioned in lines 1 and 2 above were in conformance with regulations and rules therefore as required in the current manual of survey instructions of the United States Department of the Interior, Bureau of Land Management or by a decree of a Court of Law and/or that the corner points mentioned in lines 3, 4 and 5 above were in conformance with the rules of the Michigan Board of Land Surveyors or by a Decree of a Court of Law, established, re-established, monumented, recovered, found as expressed below.

NOTE: Not more than 2 corners, all in the same town and range, may be recorded on this certificate.

A. Description of original monument and accessories and/or subsequent restoration:

I-10 1/4 Corner Common to Sections 26 and 27
G.L.O. July 1837 by John Mullett
Set 1/4 Section Post
Beech 10" N73°E 6 Links
W. Oak 9" N16°W 35 Links

LCRC Liber 4, Page 302 April 1982
Fd. Iron Bar, Set Cast Iron Monument
10" Oak S. 2.61'
13" Poplar E. 37.04'
18" Oak N.W. 35.47'
10" Maple W.S.W. 34.52'

B. Description of corner evidence found and/or method applied in restoring or reestablishing corner:


I-10 1/4 Corner Common to Sections 26 and 27
Found Cast Iron Monument
Found 10" Oak S. 2.61"
Found 13" Poplar E. 37.04'

P.A. 345 OTTAWA COUNTY
PEER APPROVED 12-9-96
C.P. Englert Jr.

Accepted as a careful and faithful perpetuation of the original position of the corner.

C. Description of monument for corner and accessories established to perpetuate locating the position of the corner:

4" Harrison Cast Iron Monument 3" deep	
O.C. Remon tag & nail in S. Side 10" Oak	S60°E 50.91'
O.C. Remon tag & nail in W. Side 22" Ash	N25°E 54.74'
O.C. Remon tag & nail in W. Side 12" Oak	S 8°W 2.69'
O.C. Remon tag & nail in S. Side Tw. 12" Maple	N86°W 43.46'
Occupation lines E & W	
Centerline of 2 track road North	

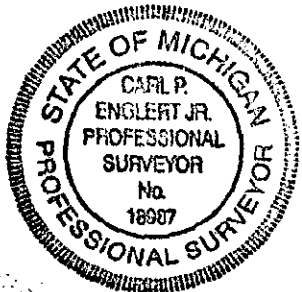

Signed by Carl P. Englert Jr.
Surveyor's Michigan License No. 18987

Date 9/16/1996