

SURVEY & REMONUMENTATION

APR 24 1995

OTTAWA COUNTY REMONUMENTATION LAND CORNER RECORDATION CERTIFICATE

RECORDED
94 DEC 15 AM 11:48

Filing Requirement of Act 74, Mich. P.A. 1970

For corners in **COMMISSION**
Ottawa
(County)

Politically Robinson Twp.
Located in: Corner Code #
Crockery Twp.

Robert Kellman
REGISTER OF DEEDS
OTTAWA COUNTY, MI

- 1. Public Land Survey T 8N R 15W I-12
T ___ R ___ E 1/4 corner
T ___ R ___ Section 34
T ___ R ___
- 2. Property Controlling S ___ T ___ R ___
in Section S ___ T ___ R ___
- 3. Miscellaneous S ___ T ___ R ___
Property in Sec. S ___ T ___ R ___

Register of Deeds Stamp & File Number

- 4. Lot No. _____, Recorded Plat _____
- 5. Private Claims _____

I, Carl P. Englert in a field survey on December 08, 19 94, do hereby certify that under requirements of P.A. 74, Michigan P.A. of 1970, the corner points mentioned in lines 1 and 2 above were in conformance with regulations and rules therefore as required in the current manual of survey instructions of the United States Department of the Interior, Bureau of Land Management or by a decree of a Court of Law and/or that the corner points mentioned in lines 3, 4 and 5 above were in conformance with the rules of the Michigan Board of Land Surveyors or by a Decree of a Court of Law; established, re-established, monumented, re-monumented, recovered, found as expressed below:

	A	B	C	D	E	F	G	H	I	J	K	L	M
2	6		5		4		3		2		1		
3													
4	7		8		9		10		11		12		
5													
6	18		17		16		15		14		13		
7													
8	19		20		21		22		23		24		
9													
10	30		29		28		27		26		25		
11													
12	31		32		33		34		35		36		
13													

NOTE: Not more than 4 corners, all in the same town and range, may be recorded on this certificate.

A. Description of original monument and accessories and/or subsequent restoration:

I-12 1/4 corner common to Sections 34 & 35
Original Gov't corner set May, 1832 by Calvin Britain, D.S. LCRC Liber 5, Page 56 (6/21/83)
4"x36" Conc.Mon. with Alum. Cap
N75°W 13.15' 12" Hackberry
S 5°E 8.91' 18" Maple
S35°E 11.81' 9" Hackberry
EAST 1.80' 5" Hackberry

Set 1/2 Mile Post
Black Ash 10" S51°W 48 Links
Black Ash 6" S42°E 49 Linka

B. Description of corner evidence found and/or method applied in restoring or reestablishing corner:

I-12 1/4 corner common to Sections 34 & 35
Found 4"x36" Conc. Mon. with Aluminum Cap Marked DNR 34 & 35 DLB 186.55
Found N75°W 13.15' 12" Hackberry (No Nail)
Found S 5°E 8.91' Dead Tree
Found S35°E 11.81' 9" Hackberry
Found EAST 1.80' 5" Hackberry

Accepted as a careful and faithful perpetuation of the original position of the corner.


PEER APPROVED 12/12/94
Wesley D. Newbold

C. Description of monument for corner and accessories established to perpetuate locating the position of the corner:

I-12 1/4 corner common to Sections 34 & 35
4"x36" Conc. Mon. with alum. Cap. marked DNR 34 & 35 DLB 18655
O.C. Remon. Tag & Nail in E. side 13" Hackberry S35°E 11.81'
O.C. Remon. Tag & Nail in N.E. side 15" Hackberry N75°W 12.95'
O.C. Remon. Tag & Nail in S. side 9" Hackberry EAST 1.80'
O.C. Remon. Tag & Nail in S. side 8" Hackberry N50°E 34.96'
O.C. Remon. Tag & Nail in E. side 9" Ash N15°W 28.98'

Signed by Carl P. Englert Jr.
Surveyor's Michigan License No. 10957

Date 12/11/94

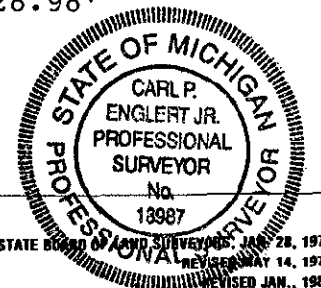

FORM APPROVED BY MICHIGAN STATE BOARD OF LAND SURVEYORS, JAN. 28, 1971
REVISED MAY 14, 1975
REVISED JAN., 1983