

**SURVEY &
REMONUMENTATION**

APR 25 1995

COMMISSION

OTTAWA COUNTY REMONUMENTATION
LAND CORNER RECORDATION CERTIFICATE
Filing Requirement of Act 74, Mich. P.A. 1970

RECORDED

94 DEC -8 PM 12:37

Phyllis Robinson
REGISTER OF DEEDS
OTTAWA COUNTY, MI

For corners in

<u>Ottawa</u> (County)	Located In: <u>Crockery Twp</u>	Corner Code # <u>J-3</u>
1. Public Land Survey	T <u>8N</u> R <u>15W</u>	<u>J-3</u>
	T ___ R ___	<u>N 1/4 Corner</u>
	T ___ R ___	<u>Section 11</u>
	T ___ R ___	_____
2. Property Controlling in Section	S ___ T ___ R ___	_____
	S ___ T ___ R ___	_____
3. Miscellaneous Property in Sec.	S ___ T ___ R ___	_____
	S ___ T ___ R ___	_____

Register of Deeds Stamp & File Number

1. Lot No. _____, Recorded Plat _____
2. Private Claims _____

A	B	C	D	E	F	G	H	I	J	K	L	M
2	6	5	4	3	2	1						
3												
4	7	8	9	10	11	12						
5												
6	18	17	16	15	14	13						
7												
8	19	20	21	22	23	24						
9												
10	30	29	28	27	26	25						
11												
12	31	32	33	34	35	36						
13												

Carl P. Englert, in a field survey on March 1 16, 1994,
to hereby certify that under requirements of P.A. 74, Michigan P.A. of 1970, the corner points mentioned
in lines 1 and 2 above were in conformance with regulations and rules therefore as required in the
current manual of survey instructions of the United States Department of the Interior, Bureau of Land
Management or by a decree of a Court of Law and/or that the corner points mentioned in lines 3, 4 and 5
above were in conformance with the rules of the Michigan Board of Land Surveyors or by a Decree of a
Court of Law; established, re-established, monumented, re-monumented, recovered, found as
expressed below:

**NOTE: Not more than 4 corners, all in the same town and range, may be recorded
on this certificate.**

A. Description of original monument and accessories and/or subsequent restoration:

J-3 1/4 corner common to Sections 2 and 11.
Original Gov't corner set in March, 1837
by John Mullet
Set Post
Hemlock 6" S19°E 4 links
Beech 11" N31°W 3 links

LCRC Liber 5, Page 71 (12/20/83)
Fd. Iron Pipe, Set C.I.M.
14" Hemlock S.E. 6.26'
10" Aspen N. 14.33'
TW. Yellow Birch N.W. 22.61'
8" Maple E. 33.27'
8" Aspen S.S.W. 12.99'

(See Back of Page)

B. Description of corner evidence found and/or method applied in restoring or reestablishing corner:


J-3 1/4 corner common to Sections 2 and 11.
Found 4" Harrison Cast Iron Monument
Found 14" Hemlock 6.26' S.E.
Found 10" Aspen N. 14.33'
Found 8" Maple E. 33.27'

P.A. 345 OTTAWA COUNTY
PEER APPROVED 11/21/94

Accepted as a careful and faithful perpetuation of the position of
the original corner.

C. Description of monument for corner and accessories established to perpetuate locating the position of the corner:

J-3 1/4 corner common to Sections 2 and 11.
4" Harrison Cast Iron Monument
O.C. Remon. Tag & Nail in E. Side 14" Aspen N10°W 14.20'
O.C. Remon. Tag & Nail in W. Side 8" Maple S 10.09'
O.C. Remon. Tag & Nail in N. Side 10" Maple S70°E 33.26'
O.C. Remon. Tag & Nail in N.E. Side 20" Maple N52°W 34.65'
Capped Iron Bar South 16.50'
Centerline Creek South 19' +/-

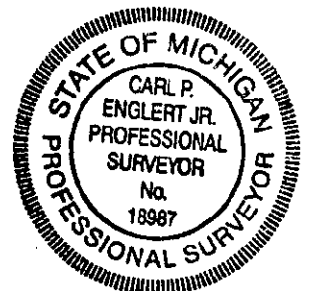

Signed by Carl P. Englert Jr.
Surveyor's Michigan License No. 18987

Date 11/21/94

A. Description of original monument and accessories and/or subsequent restoration.

J-3 LCRC Liber 2, Page 7 (1/23/73)

Fd. Iron Post in Fence Corner

Set Iron Pipe

N.W. 21.95' TW. Birch

N. 8" Aspen 14.31'

S.W. 9" ASpen 26.60'

S.E. 6.25' 16" Hemlock

16-54
CORNER
CORNER
CORNER
CORNER