

SURVEY & REMONUMENTATION

FEB 27 1998

OTTAWA COUNTY REMONUMENTATION
LAND CORNER RECORDATION CERTIFICATE
Filing Requirement of Act 74, Mich. P.A. 1970

RECORDED

97 OCT 30 AM 11:01

For corners in **SECTION**

<u>Ottawa</u> <small>(County)</small>	Located In: Crockery Township	Corner Code #	
1. Public Land Survey	T <u>8N</u> R <u>15W</u>	<u>J-11</u>	<u>S 1/4 corner</u> <u>Section 26</u>
	T ___ R ___		
	T ___ R ___		
	T ___ R ___		
2. Property Controlling in Section	S ___ T ___ R ___		
	S ___ T ___ R ___		
3. Miscellaneous Property in Sec.	S ___ T ___ R ___		
	S ___ T ___ R ___		

Debra Gant

Register of Deeds
Ottawa County, MI

Register of Deeds Stamp & File Number

4. Lot No. _____, Recorded Plat _____
5. Private Claims _____

I, Carl P. Englert, in a field survey on 3/5, 19 97 do hereby state that under requirements of P.A. 74, Michigan P.A. of 1970, the corner points mentioned in lines 1 and 2 above were in conformance with regulations and rules therefore as required in the current manual of survey instructions of the United States Department of the Interior, Bureau of Land Management or by a decree of a Court of Law and/or that the corner points mentioned in lines 3, 4 and 5 above were in conformance with the rules of the Michigan Board of Land Surveyors or by a Decree of a Court of Law, established, re-established, monumented, recovered, found as expressed below:

NOTE: Not more than 2 corners, all in the same town and range, may be recorded on this certificate.

	A	B	C	D	E	F	G	H	I	J	K	L	M
1													
2		6		5		4		3		2		1	
3													
4		7		8		9		10		11		12	
5													
6		18		17		16		15		14		13	
7													
8		19		20		21		22		23		24	
9													
10		30		29		28		27		26		25	
11										35			
12		31		32		33		34		35		36	
13													

A. Description of original monument and accessories and/or subsequent restoration:

J-11 1/4 corner common to Sections 26 & 35
 G.L.O. 1837 John Mullett LCRC Liber 1, Page 531 (8/19/72)
 Beech 11" 1/4 Section Post Iron Stake (could not find)
 Set 5/8" Rod on centerline of Road
 at Stump Fence Line South
 ESE 43.25' Tw.Oak
 SE 45.58' 8" Aspen
 S 28.33' Twin Cherry

See Other Side

B. Description of corner evidence found and/or method applied in restoring or reestablishing corner:

J-11 1/4 corner common to Sections 26 & 35
 Found 4" Harrison Cast Iron Monument with Broken Top 3" deep
 in centerline of Gravel Road
 Found Twin 11" Cherry S 28.29'
 Found Twin 14" Oak ESE 44.00'

P.A. 345 OTTAWA COUNTY
PEER APPROVED 9-15-97


Accepted as a careful and faithful perpetuation of the original position of the corner.

C. Description of monument for corner and accessories established to perpetuate locating the position of the corner:

J-11 1/4 corner common to Sections 26 & 35
 4" Harrison Cast Iron Monument with Broken Top
 O.C. Remon Tag & Nail in W Side 11" Pine N37°E 51.98'
 O.C. Remon Tag & Nail in E Side 12" Aspen S35°W 41.47'
 O.C. Remon Tag & Nail in W Side 10" Elm S14°W 37.28'
 O.C. Remon Tag & Nail in SW Side 13" Oak S54°E 60.98'

Signed by Carl P. Englert Jr
 Surveyor's Michigan License No. 118987

Date 9/15/97

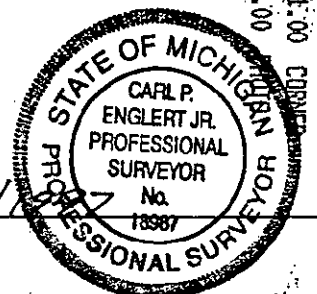

J-11 Town 8 North, Range 15 West
LCRC Liber 4, Page 123 (11/26/80)
Found 5/8" Iron Bar, Set Cast Iron Monument
Twin 11" Cherry South 28.29'
8" Aspen SW 41.29'
Twin 14" Oak ESE 44.00'

**SURVEY &
REMONUMENTATION**

FEB 27 1998

SECTION