

# SURVEY & REMONUMENTATION

OCT 07 1996

COMMISSION

## OTTAWA COUNTY REMONUMENTATION LAND CORNER RECORDATION CERTIFICATE Filing Requirement of Act 74, Mich. P.A. 1970

For corners in

Ottawa (County)	Located In: Crockery Twp.	Corner Code #
1. Public Land Survey	T <u>8N</u> R <u>15W</u>	<u>K-2</u>
	T <u>    </u> R <u>    </u>	<u>E 1/4 corner</u>
	T <u>    </u> R <u>    </u>	<u>Section 2</u>
	T <u>    </u> R <u>    </u>	<u>    </u>
2. Property Controlling in Section	S <u>    </u> T <u>    </u> R <u>    </u>	<u>    </u>
	S <u>    </u> T <u>    </u> R <u>    </u>	<u>    </u>
3. Miscellaneous Property in Sec.	S <u>    </u> T <u>    </u> R <u>    </u>	<u>    </u>
	S <u>    </u> T <u>    </u> R <u>    </u>	<u>    </u>

RECORDED

96 AUG 26 PM 2:03

*Richard S. Holloman*  
REGISTER OF DEEDS  
OTTAWA COUNTY, MI

Register of Deeds Stamp & File Number

4. Lot No. \_\_\_\_\_, Recorded Plat \_\_\_\_\_  
5. Private Claims \_\_\_\_\_

I, Carl P. Englert, Jr., in a field survey on 11/16, 19 95 do hereby state that under requirements of P.A. 74, Michigan P.A. of 1970, the corner points mentioned in lines 1 and 2 above were in conformance with regulations and rules therefore as required in the current manual of survey instructions of the United States Department of the Interior, Bureau of Land Management or by a decree of a Court of Law and/or that the corner points mentioned in lines 3, 4 and 5 above were in conformance with the rules of the Michigan Board of Land Surveyors or by a Decree of a Court of Law; established, re-established, monumented, recovered, found as expressed below:

	A	B	C	D	E	F	G	H	I	J	K	L	M
1													
2	6		5		4		3		2		1		
3													
4	7		8		9		10		11		12		
5													
6	18		17		16		15		14		13		
7													
8	19		20		21		22		23		24		
9													
10	30		29		28		27		26		25		
11													
12	31		32		33		34		35		36		
13													

NOTE: Not more than 2 corners, all in the same town and range, may be recorded on this certificate.

A. Description of original monument and accessories and/or subsequent restoration:  
K-2 1/4 corner common to Section 1 & 2  
Original corner set March 1837 by John Mullett  
Set 1/4 section post  
White Ash, 8" N 64° W 31 links  
White Ash, 8" S 55° W 52 links

LCRC Liber 2, Page 251, 8/4/1973  
Set 5/8" rod on line between Section corners  
at E & W fence lines  
NE 24" Oak 39.02'  
NW 8" Ash 50.17'  
SE 7" Ash 23.38'  
SW 8" Willow 40.82'

SEE OTHER SIDE

P.A. 345 OTTAWA COUNTY  
PEER APPROVED 8-20-96  
*Harvey D. Mederwald*

B. Description of corner evidence found and/or method applied in restoring or reestablishing corner:


K-2 1/4 corner common to Sections 1 & 2  
Found 4" cast iron monument with top broken off 10" deep in gravel road  
Found 24" Oak NE 39.02'  
Found 26" Oak NE 27.74'  
Found 10" Ash SE 23.44'  
Found 10" Willow SW 40.77'  
Fence line West  
Accepted as a careful and faithful perpetuation of the position of the original corner

C. Description of monument for corner and accessories established to perpetuate locating the position of the corner:

K-2 1/4 corner common to Sections 1 & 2  
4" cast iron monument with top broken off 10" deep  
Ottawa County Remonumentation tag and nail in SE side 26" Oak N 41° E 28.45'  
Ottawa County Remonumentation tag and nail in S side 10" Ash S 49° E 23.52'  
Ottawa County Remonumentation tag and nail in SE side 10" Willow S 42° W 40.70'  
Ottawa County Remonumentation tag and nail in NE side 8" Ash N 36° W 54.45'  
Ottawa County Remonumentation tag and nail in centerline of gravel road

Signed by Carl P. Englert Jr.  
Surveyor's Michigan License No. 18987

Date 11/20/1995

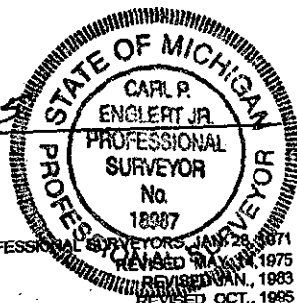

FORM APPROVED BY MICHIGAN STATE BOARD OF PROFESSIONAL SURVEYORS, JAN 23, 1971  
REVISED MAY 14, 1975  
REVISED JAN, 1983  
REVISED OCT, 1985

K-2 Town 8 North, Range 15 West  
LCRC Liber 4, Page 95, 7/15/1980  
Found 5/8" steel rod  
Set cast iron monument  
26" Oak NE 27.74'  
8" Ash NW 50.43'  
7" Ash SE 23.44'  
8" Willow SW 40.77'

SURVEY &  
REMONUMENTATION

OCT 07 1996

COMMISSION

\* 11.00 CORNER  
\* 1.00 PHOTO  
\* 1.00 PHOTO