

SURVEY & REMONUMENTATION

APR 25 1995

OTTAWA COUNTY REMONUMENTATION
LAND CORNER RECORDATION CERTIFICATE
Filing Requirement of Act 74, Mich. P.A. 1970

RECORDED

94 DEC -8 PM 12:37

COMMISSION

Richard L. Williams
REGISTER OF DEEDS
OTTAWA COUNTY, MI

For corners in

<u>Ottawa</u> (County)	Located In: <u>Crockery Twp</u>	Corner Code # <u>K-5</u>
1. Public Land Survey	T <u>8N</u> R <u>15W</u>	<u>SE Corner</u> <u>Section 11</u>
	T ___ R ___	_____
	T ___ R ___	_____
	T ___ R ___	_____
2. Property Controlling in Section	S ___ T ___ R ___	_____
	S ___ T ___ R ___	_____
3. Miscellaneous Property in Sec.	S ___ T ___ R ___	_____
	S ___ T ___ R ___	_____

Register of Deeds Stamp & File Number

4. Lot No. _____, Recorded Plat _____
5. Private Claims _____

	A	B	C	D	E	F	G	H	I	J	K	L	M
2	6	5	4	3	2	1							
3													
4	7	8	9	10	11	12							
5													
6	18	17	16	15	14	13							
7													
8	19	20	21	22	23	24							
9													
10	30	29	28	27	26	25							
11													
12	31	32	33	34	35	36							
13													

Carl P. Englert in a field survey on March 16, 1994, do hereby certify that under requirements of P.A. 74, Michigan P.A. of 1970, the corner points mentioned in lines 1 and 2 above were in conformance with regulations and rules therefore as required in the current manual of survey instructions of the United States Department of the Interior, Bureau of Land Management or by a decree of a Court of Law and/or that the corner points mentioned in lines 3, 4 and 5 above were in conformance with the rules of the Michigan Board of Land Surveyors or by a Decree of a Court of Law, established, re-established, monumented, re-monumented, recovered, found as expressed below:

NOTE: Not more than 4 corners, all in the same town and range, may be recorded on this certificate.

A. Description of original monument and accessories and/or subsequent restoration:

K-5 corner common to Sections 11, 12, 13 & 14.
Original gov't corner set in March 1837
by John Mullet
Set Post
Sugar 16" S9.5°E 1.55 Chains
Beech 8" N85°E 1.55 Chains

Liber 5, Page 343 (12/6/88)
Fd. 1" Iron Bar, Set C.I.M.
6" Locust S.S.W. 39.80'
T.P. S.W. 53.97'
Chiseled X in Conc. Bridge
Headwall W.S.W. (No Distance)
Chiseled X in Conc. Bridge
Headwall W.N.W. (No Distance)

(See Back of Page)

B. Description of corner evidence found and/or method applied in restoring or reestablishing corner:

K-5 corner common to Sections 11, 12, 13 and 14.
Found 4" Harrison C.I.M.
Found "X" in Conc. Bridge Headwall W.S.W.
Found "X" in Conc. Bridge Headwall W.N.W.
T.P. S.W. 53.97'

Accepted as a careful and faithful perpetuation of the position of the original corner.


P.A. 345 OTTAWA COUNTY

PEER APPROVED 11/21/94

Madison P. Hedrowald

C. Description of monument for corner and accessories established to perpetuate locating the position of the corner:

K-5 Corner common to Sections 11, 12, 13 and 14.
4" Harrison Cast Iron Monument 6" deep
"X" in N.E. concrete Bridge abutment N69°W 60.06'
"X" in S.E. concrete Bridge abutment S69°W 60.11'
O.C. Remon Tag & Nail in N.W. side T.P. S61°W 54.00'
O.C. Remon Tag & Nail in N. side T.P. S80°E 117.52'
O.C. Remon Tag & Nail in N. side 14" Yew North 79°E 341.28'
Centerline gravel road 3' +/- North

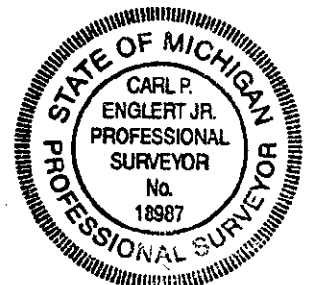

Signed by Carl P. Englert Jr.
Surveyor's Michigan License No. 18987

Date 11/17/94

A. Description of original monument and accessories and/or subsequent restoration.

K-5 Liber 2, Page 77 (3/23/73)

Fd. 2" Iron Pipe

20" Maple W.S.W. 42.17'

20" Basswood W.N.W. 65.78'

8" Basswood N.E. 23.20'

Bridge Rail N.W. 20.25'

7/23/73
CASE #
7/23/73