

REMO

DEC 01 1998

OTTAWA COUNTY REMONUMENTATION
LAND CORNER RECORDATION CERTIFICATE
Filing Requirement of Act 74, Mich. P.A. 1970

SECTION

For corners in

Ottawa
(County)

Located in: Crockery Twp. Corner Code # **K-13**

1. Public Land Survey

T 8 N R 15 W

SW Corner
Section 36

T R

T R

T 7 N R 15 W

K-1

2. Property Controlling
in Section

S T R

COMMON CORNER
TO K-1, T 7 N, R 15 W

S T R

3. Miscellaneous
Property in Sec.

S T R

S T R

RECORDED
98 JUL 24 PM 1:45

Sam Schell
REGISTER OF DEEDS
OTTAWA COUNTY MI
Register of Deeds Stamp & File
Number

4. Lot No. _____, Recorded Plat _____
5. Private Claims _____

I, Robert E. Lenke, in a field survey on November 17, 1997 do hereby state that under requirements of P.A. 74, Michigan P.A. of 1970, the corner points mentioned in lines 1 and 2 above were in conformance with regulations and rules therefore as required in the current manual of survey instructions of the United States Department of the Interior, Bureau of Land Management or by a decree of a Court of Law and /or that the corner points mentioned in lines 3, 4 and 5 above were in conformance with the rules of the Michigan Board of Land Surveyors or by a Decree of a Court of Law; established, re-established, monumented, recovered, found as expressed below:

NOTE: Not more than 2 corners, all in the same town and range, may be recorded on this certificate.

	A	B	C	D	E	F	G	H	I	J	K	L	M
1													
2	6			5		4			3		2		1
3													
4	7			8		9			10		11		12
5													
6	18			17		16			15		14		13
7													
8	19			20		21			22		23		24
9													
10	30			29		28			27		26		25
11													
12	31			32		33			34		35		36
13													

A. Description of original monument and accessories and/or subsequent restoration:

K-13 GLO
80.00 Set mile post
Pine 30" S 42° E 18 Lks
Pine 20" S 25° W 20 Lks
May 11th 1832
By Calvin Britain

L.C.R.C.-L2, P 267
John Clapp. 6/26/73- Fd. Crockery, Marble, Plow
Point, Set Cast Iron Monument
(a) 12" Cherry NNW 36.49'
(b) Iron W 33.00'
(c) Steel bar at CL Cedar Street S 277.51'

Survey Card Holland Engineering
C.I.M. J. Kistler & Assoc. 1973
Same as L.C.R.C.-L2, P267

Act 132 Survey
John Kistler & Assoc.
L1, P 799-6/26/73
Same wit's as shown on
LCRC L2-P267

Act 132 Survey
John Kistler & Assoc.
L1, P 837-7/5/73
Same wit's as shown on
LCRC L2-P267

Act 132 Survey
Exxel Engineering Co.
L4, P 454-10/15/79
Same wit's as shown on
LCRC L2-P267

PA. 345 OTTAWA COUNTY
PEER APPROVED 4-20-98
YD

B. Description of corner evidence found and/or method applied in restoring or reestablishing corner:

K-13- Common with northwest corner of section 31, T.7 N.- R.15W. J. Mullett, D.S. in 1837 assumes the corner set as said northwest corner by Calvin Britain May 11th 1832 is a corner common to Sections 35 & 36 T.8 N.- R.15W and Sections 1 & 2 T.7 N.- R.15W. After making this assumption he heads East 80.00 chains and intersects the E boundary 38 links north of the temporary post. Based on Mullett's notes. I accept K-1 as the corner common to both townships. The corner is a 4" cast iron monument with 2 witness's as per LCRC L2-P267, and is accepted as a careful and faithful perpetuation of the position of the original corner.

C. Description of monument for corner and accessories established to perpetuate locating the position of the corner:


K-13 Found 4" cast iron monument.
Found Steel bar on section line South 277.51' in centerline of Cedar Street. Same as (c) LCRC L2-P267
Found "T" iron West 33.02' same as (b) LCRC L2-P267
Set nail and 2" washer in E side of 8" Cherry 1.6' above grade N 25° W 40.59'
Found nail and washer in E side of 30" Cherry 2.6' above grade N 15° E 37.25'
Set nail and 2" washer in 12" Apple 0.4' above grade S 85° W 44.45'

Signed by *Robert E. Lenke*

Date 4/20/98

\$9.00 CORNER
Receipt #5013

Surveyor's Michigan License No. 40160 for SDI CONSULTANTS LTD.

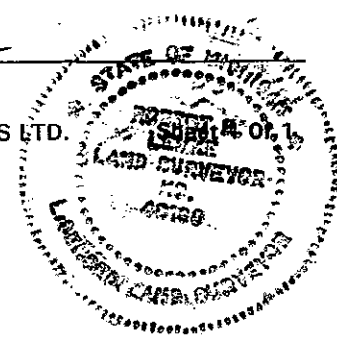

FORM APPROVED BY MICHIGAN STATE BOARD
OF PROFESSIONAL SURVEYORS, JAN. 28, 1971
REVISED MAY 14, 1976 REVISED
JAN., 1983
REVISED OCT., 1995