


SURVEY &
REMONUMENTATION

DEC 01 1998

SECTION

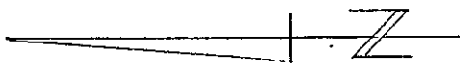

S 1/4 SEC. 36
T. 8N R. 15W



COMMON CORNER

2648.64 FT.

SW COR. SEC. 36
T. 8N R. 15W
K13

COMMON CORNER

NW COR. SEC. 1
T. 7N R. 15W

K1

2665.21 FT.

SEC. COR. SEC. 36
T. 8N R. 15W
M13

COMMON CORNER

M1

N 1/4 SEC. 1
T. 7N R. 15W

NE COR. SEC. 1
T. 7N R. 15W