

SURVEY & REMONUMENTATION

OCT 07 1996

COMMISSION

OTTAWA COUNTY REMONUMENTATION
LAND CORNER RECORDATION CERTIFICATE
Filing Requirement of Act 74, Mich. P.A. 1970

For corners in

OTTAWA	Located in:	Corner Code #	
(County)			
	Crockery Twp.		
1. Public Land Survey	T <u>8N</u> R <u>15W</u>	<u>M-2</u>	
	T ___ R ___	<u>E 1/4 Corner</u>	
	T ___ R ___	<u>Section 1</u>	
	T ___ R ___	_____	
2. Property Controlling in Section	S ___ T ___ R ___	_____	
	S ___ T ___ R ___	_____	
3. Miscellaneous Property in Sec.	S ___ T ___ R ___	_____	
	S ___ T ___ R ___	_____	

RECORDED
96 AUG 26 PM 2: 03
Elizabeth Callman
REGISTER OF DEEDS
OTTAWA COUNTY, MI

Register of Deeds Stamp & File Number

4. Lot No. _____, Recorded Plat _____
5. Private Claims _____

I, Carl P. Englert, Jr., in a field survey on November 16 19 95 do hereby state that under requirements of P.A. 74, Michigan P.A. of 1970, the corner points mentioned in lines 1 and 2 above were in conformance with regulations and rules therefore as required in the current manual of survey instructions of the United States Department of the Interior, Bureau of Land Management or by a decree of a Court of Law and /or that the corner points mentioned in lines 3, 4 and 5 above were in conformance with the rules of the Michigan Board of Land Surveyors or by a Decree of a Court of Law; established, re-established, monumented, recovered, found as expressed below:

NOTE: Not more than 2 corners, all in the same town and range, may be recorded on this certificate.

	A	B	C	D	E	F	G	H	I	J	K	L	M
1													
2		6		5		4		3		2		1	
3													
4		7		8		9		10		11		12	
5													
6		10		17		16		15		14		13	
7													
8		19		20		21		22		23		24	
9													
10		30		29		28		27		26		25	
11													
12		31		32		33		34		35		36	
13													

A. Description of original monument and accessories and/or subsequent restoration:

<p>M-2 1/4 corner common to Section 1, T8N, R15W and Section 6, T8N, R14W Original Gov't Corner set March 1837 by John Mullett Set 1/4 Section Post B. Oak 36" S 30° W 45 Links Beech 7" N 43° W 12 Links</p>	<p>LCRC Liber 2, Page 253, 8/3/1973 Found 5/8" Rod ESE 89.3' NW corner House W. 26.36' T.P. NE 51.70' T.P.</p>
---	--

see other side

B. Description of corner evidence found and/or method applied in restoring or reestablishing corner:

M-2 1/4 corner common to Section 1, T8N, R15W and Section 6, T8N, R 14W.
Found 4" Cast Iron Monument with top broken off 3" below grade in CL of Gravel Road on Occupation Line E & W.
Found ESE NW corner of House 89.3'
Found P.P. NE 51.70'

P.A. 345 OTTAWA COUNTY
PEER APPROVED 8-20-96

Stephen P. Nedeweld


Accepted as a careful and faithful perpetuation of the original position of the corner.

C. Description of monument for corner and accessories established to perpetuate locating the position of the corner:

M-2 1/4 corner common to Section 1, T8N, R15W and Section 6, T8N, R 14W.
4" Cast Iron Monument 3" below grade in CL Gravel Road.
Ottawa County Remonumentation tag and nail in E. side P.P. N 24° W 157.38'
Ottawa County Remonumentation tag and nail in SE side P.P. N 39° E 51.56'
Ottawa County Remonumentation tag and nail in SW side 12" Maple S 52° E 51.46'
Ottawa County Remonumentation tag and nail in S. side Tele pole West 25.82'

Signed by Carl P. Englert Jr
Surveyor's Michigan License No. 18987

Date 11/20/1995

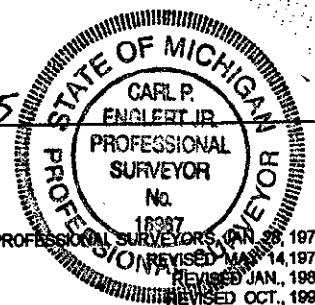

M-2 T8N, R15W
LCRC Liber 2, Page 423 11/29/73
Fd. 5/8" rod
ESE 89.3' NW Cor Hse
W. 26.36' T.P.
NE 51.70' T.P.

LCRC Liber 4, Page 97 8/12/80
Found 5/8" Iron Bar, Set Cast Iron Monument
T.P. W. 26.27'
T.P. NE 51.70'
NW Corner of House East 96.72'

SURVEY &
REMONUMENTATION

OCT 07 1996

COMMISSION

\$ 11.00 CORNER
\$ 1.00 PHOTO
\$ 1.00 PHOTO