

FEB 24 2000

SECTION

OTTAWA COUNTY REMONUMENTATION
LAND CORNER RECORDATION CERTIFICATE
Filing Requirement of Act 74, Mich. P.A. 1970

RECORDED

99 SEP 23 PM 3: 20

For corners in

OTTAWA

(County)

Located In:

Corner Code #

1. Public Land Survey

T 8N R 15W

M-3, NE corner

T R

Sec. 12, Crackerly

T R

Twp.

T R

2. Property Controlling in Section

S T R

S T R

3. Miscellaneous Property in Sec.

S T R

S T R

4. Lot No. _____, Recorded Plat _____

5. Private Claims _____

Gary Schellton
REGISTER OF DEEDS
OTTAWA COUNTY, MI

Seg. 2

Register of Deeds Stamp & File Number

I, Randal J. Vugteveen, in a field survey on August 31, 1999 do hereby state that under requirements of P.A. 74, Michigan P.A. of 1970, the corner points mentioned in lines 1 and 2 above were in conformance with regulations and rules therefore as required in the current manual of survey instructions of the United States Department of the Interior, Bureau of Land Management or by a decree of a Court of Law and /or that the corner points mentioned in lines 3, 4 and 5 above were in conformance with the rules of the Michigan Board of Land Surveyors or by a Decree of a Court of Law; established, re-established, monumented, recovered, found as expressed below:

NOTE: Not more than 2 corners, all in the same town and range, may be recorded on this certificate.

	A	B	C	D	E	F	G	H	I	J	K	L
1												
2	6		5		4		3		2		1	
3												
4	7		8		9		10		11		12	
5												
6	18		17		16		15		14		13	
7												
8	19		20		21		22		23		24	
9												
10	30		29		28		27		26		25	
11												
12	31		32		33		34		35		36	
13												

A. Description of original monument and accessories and/or subsequent restoration:

M-3 Liber 2, Page 478 Remonumentation approved October 1995 (Englert)

Corner common to Sections 6 & 7, T8N, R14W &

Sections 1 & 12, T8N, R15W

4" Cast Iron Monument

Nail Remon Tag W side 26" Spruce N 39°E 53.03'

Nail Remon Tag E side power pole S15°W 119.95'

Nail Remon Tag E side power pole N10°W 185.52'

Nail Remon Tag S side P. Pole N78°E 246.08'

B. Description of corner evidence found and/or method applied in restoring or reestablishing corner:

M-3 Found Busted Cast Iron Monument (Top 1.5' Below grade) (June 3, 1999)

Found Nail and Remon Tag in West side 28" Spruce N40°E 53.01'

Found Nail and Remon Tag in East side power pole N10°W 185.44'

Found Nail and Remon Tag in East side power pole S15°W 119.93'

Accepted busted Cast Iron Monument as a careful and faithful perpetuation of the position of the original corner.

(OCRC is rebuilding the road at this time)

Set witness iron control points outside of construction

August 31, 1999 recovered witness irons and set 3/4" X 36" Iron bar with remonumentation cap in gravel road

(Note: Found bottom of cast iron monument 0.02' West and 0.10' South of true position)

9/13/99
ADJ

C. Description of monument for corner and accessories established to perpetuate locating the position of the corner:

M-3 3/4" X 36" Iron Bar with O.C. remon cap


Found Nail and Remon Tag in West side 28" Spruce N40°E 53.01'

Found Nail and Remon Tag in East side power pole N10°W 185.44'

Found Nail and Remon Tag in East side power pole S15°W 119.93'

Capped iron bar witness S45°W 68.80'

On centerline "X" gravel road (to be paved October 1999)

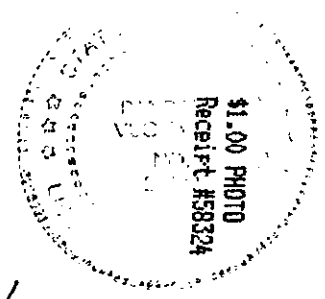

49.00 CORNER
Receipt #58324

Signed by *Randal J. Vugteveen*
Surveyor's Michigan License No. 28429

Date 9/12/99