

SURVEY & REMONUMENTATION

APR 05 1996

**OTTAWA COUNTY REMONUMENTATION
LAND CORNER RECORDATION CERTIFICATE**
Filing Requirement of Act 74, Mich. P.A. 1970

For corners in **COMMISSION** Crockery Twp

Ottawa (County)	Located In:	Corner Code #
1. Public Land Survey	T 8 N R 15 W	M - 4
	T _____ R _____	E 1/4 corner
	T _____ R _____	Section 12
	T _____ R _____	
2. Property Controlling in Section	S _____ T _____ R _____	
	S _____ T _____ R _____	
3. Miscellaneous Property in Sec.	S _____ T _____ R _____	
	S _____ T _____ R _____	

RECORDED
95 NOV 15 PM 2:05
Phyllis Hollman
REGISTER OF DEEDS
OTTAWA COUNTY, MI
Register of Deeds Stamp & File Number

4. Lot No. _____, Recorded Plat _____
5. Private Claims _____

	A	B	C	D	E	F	G	H	I	J	K	L	M
2	6		5		4		3		2		1		
3													
4	7		8		9		10		11		12		
5													
6	18		17		18		15		14		13		
7													
8	19		20		21		22		23		24		
9													
10	30		29		28		27		26		25		
11													
12	31		32		33		34		35		36		
13													

I, Carl P. Englert, Jr., in a field survey on October 9, 1995, do hereby certify that under requirements of P.A. 74, Michigan P.A. of 1970, the corner points mentioned in lines 1 and 2 above were in conformance with regulations and rules therefore as required in the current manual of survey instructions of the United States Department of the Interior, Bureau of Land Management or by a decree of a Court of Law and/or that the corner points mentioned in lines 3, 4 and 5 above were in conformance with the rules of the Michigan Board of Land Surveyors or by a Decree of a Court of Law; established, re-established, monumented, re-monumented, recovered, found as expressed below:

NOTE: Not more than 4 corners, all in the same town and range, may be recorded on this certificate.

A. Description of original monument and accessories and/or subsequent restoration:

M - 4 1/4 Corner common to Section 12, T 8 N, R 15 W & Section 7, T 8 N, R 14 W.
Original Corner set March 1837 by John Mullett D.S.
Set 1/4 Section Post
Sugar 13" S 32° W 5 Links
Elm 12" N 21° W 11 Links
LCRC Liber 2, Page 67 Feb. 15, 1973
Fd. Bent Iron Pipe, Set 5/8" Rod
NW 36.70' Tw. Maple
NE 63.67' 8" Ash
NE 24.80' 6" Ash
SE 47.28' 12" Ash
see other side

B. Description of corner evidence found and/or method applied in restoring or reestablishing corner:

M - 4 1/4 Corner common to Section 12, T 8 N, R 15 W & Section 7, T 8 N, R 14 W.
Found 4" CIM 10" deep in CL Gravel Road
Found Nail in top of fencepost E. 30.30'± (Post Leaning)
Found 18" Twin Basswood (Ash) WNW 37.33'
Found 6" Elm SW 41.45'

Accepted as a careful and faithful perpetuation of the position of the original corner.


P.A. 345 OTTAWA COUNTY
PEER APPROVED 10/23/95
Gregory D. Hedewell

C. Description of monument for corner and accessories established to perpetuate locating the position of the corner:

M - 4 1/4 corner common to Section 12, T 8 N, R 15 W & Section 7, T 8 N, R 14 W.
4" CIM
Ottawa County Remonumentation Tag and Nail in W. Side 6" Maple S 15° E 135.67'
Ottawa County Remonumentation Tag and Nail in SE Side 6" Elm S 41° W 41.45'
Ottawa County Remonumentation Tag and Nail in N. Side 18" Twin Basswood N 64° W 37.69'
Ottawa County Remonumentation Tag and Nail in E. Side 24" Maple N 24° W 66.18'
Ottawa County Remonumentation Tag and Nail in W. Side 6" Ash N 16° E 83.34'

Signed by Carl P. Englert Jr.
Surveyor's Michigan License No. 18987

Date 10/17/1995

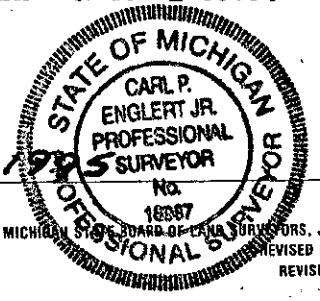

FORM APPROVED BY MICHIGAN STATE BOARD OF LAND SURVEYORS, JAN. 28, 1971
REVISED MAY 14, 1974
REVISED JAN., 1982

A - 4 Polkton Twp T 8 N, R 14 W
M - 4 Crockery Twp T 8 N, R 15 W
LCRC Liber 4, Page 98 August 12, 1980.
Found Iron Bar, Set CIM
Nail in top of Fence post East 30.30'
Tw. 16" Maple NW 64.66'
18" Ash WNW 37.33'

\$ 11.00 CORNER