

FEB 24 2000

RECORDED

99 SEP 23 PM 3: 20

SECTION

OTTAWA COUNTY REMONUMENTATION
LAND CORNER RECORDATION CERTIFICATE
Filing Requirement of Act 74, Mich. P.A. 1970

Gary Schellman
REGISTER OF DEEDS
OTTAWA COUNTY, MI

For corners in

OTTAWA
(County)

Located In:

Corner Code #

- 1. Public-Land Survey T8N R 15W M-5, NE corner
 T R Sec. 13, Crockery
 T R Twp
- 2. Property Controlling S T R COMMON CORNER
 in Section S T R WITH A-5 OF
- 3. Miscellaneous S T R FOLKTON TWP
 Property in Sec. S T R

Register of Deeds Stamp & File Number

4. Lot No. _____, Recorded Plat _____
5. Private Claims _____

I, Randal J. Vugteveen, in a field survey on August 31, 19 99 do hereby state that under requirements of P.A. 74, Michigan P.A. of 1970, the corner points mentioned in lines 1 and 2 above were in conformance with regulations and rules therefore as required in the current manual of survey instructions of the United States Department of the Interior, Bureau of Land Management or by a decree of a Court of Law and /or that the corner points mentioned in lines 3, 4 and 5 above were in conformance with the rules of the Michigan Board of Land Surveyors or by a Decree of a Court of Law; established, re-established, monumented, recovered, found as expressed below:

NOTE: Not more than 2 corners, all in the same town and range, may be recorded on this certificate.

1	A	B	C	D	E	F	G	H	I	J	K	L
2	6		5		4		3		2		1	
3												
4	7		8		9		10		11		12	
5												
6	18		17		16		15		14		13	
7												
8	19		20		21		22		23		24	
9												
10	30		29		28		27		26		25	
11												
12	31		32		33		34		35		36	
13												

A. Description of original monument and accessories and/or subsequent restoration:

M-5 GLO March 1837
John Mullett
Set post
9" Birch S23°W 32 Links
20" Sugar Maple N14°W 22 Links

M-5 Liber 4, Page 271
Joiner December 3, 1981
Set Cast Iron Monument
10" Ash W 39.40'
14" Maple NE 82.70'
Telephone Pole W 24.35'
Twin Ash SE 87.35'

9/13/99
RDJ

B. Description of corner evidence found and/or method applied in restoring or reestablishing corner:

M-5 Found Cast Iron Monument (June 3, 1999)

Fnd Nail & Remon Tag W side 16" Maple NE 82.70'
Fnd Nail & Remon Tag N side telephone pole (cut off) West 24.35'
Center of stump SE 87.5'


Accepted Cast Iron Monument as a careful and faithful perpetuation of the position of the original corner
(OCRC is rebuilding road at this time) set witness iron control points outside of construction

August 31, 1999 recovered witness irons and set 3/4" X 24" iron bar with remonumentation cap in new gravel road

C. Description of monument for corner and accessories established to perpetuate locating the position of the corner:

M-5 3/4" X 24" iron bar with Ottawa County Remon Cap

Set Nail and Remon Tag in NW side 5" Maple N45°E 77.31'
Set Nail and Remon Tag in NE side Twin 12" Apple N64°W 46.35'
Set Nail and Remon Tag in E side telephone pole N12°W 169.86'
Set Nail and Remon Tag in S side corner fence post N90°E 34.79'
On centerline gravel (to be paved October 1999) Road
On center of old fence lines to East and West

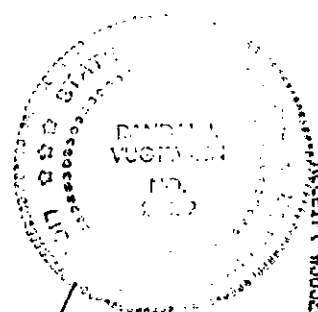

11.0V FRUIT
Receipt #58324

\$9.00 CORNER
Receipt #58324

Signed by *Randal J. Vugteveen*
Surveyor's Michigan License No. 28429

Date 9/12/99