OTTAWA COUNTY REMONUMENTATION

RECORDED

93 DEC 15 AM 9:31

REGISTER OF DEEDS
OTTAWA COUNTY, MI

LAND CORNER RECORDATION CERTIFICATE
Filing Requirement of Act 74, Mich. P.A. 1970

For corners in Ottawa (County)

	Located In:	Corner Code #
	Crockery Township	
1. Public Land Survey	T 8N R 15W	M-8
	T ___ R ___	E¼ Corner
	T ___ R ___	Section 24
	T ___ R ___	
2. Property Controlling	S ___ T ___ R ___	
in Section	S ___ T ___ R ___	
3. Miscellaneous	S ___ T ___ R ___	
Property in Sec.	S ___ T ___ R ___	

Register of Deeds Stamp & File Number

4. Lot No. _____, Recorded Plat _____
5. Private Claims _____

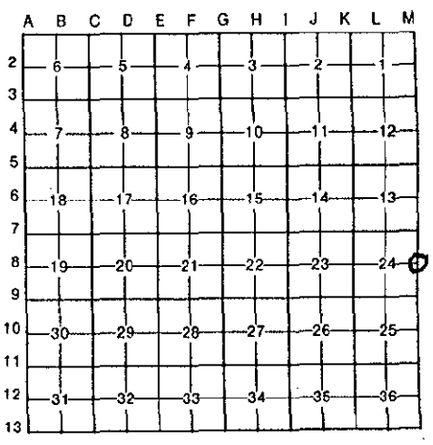

I, Carl P. Englert Jr., in a field survey on August 5, 19 93, do hereby certify that under requirements of P.A. 74, Michigan P.A. of 1970, the corner points mentioned in lines 1 and 2 above were in conformance with regulations and rules therefore as required in the current manual of survey instructions of the United States Department of the Interior, Bureau of Land Management or by a decree of a Court of Law and/or that the corner points mentioned in lines 3, 4 and 5 above were in conformance with the rules of the Michigan Board of Land Surveyors or by a Decree of a Court of Law; established, re-established, monumented, re-monumented, recovered, found as expressed below:

NOTE: Not more than 4 corners, all in the same town and range, may be recorded on this certificate.

A. Description of original monument and accessories and/or subsequent restoration:

M-8 L.C.R.C., Liber 6, Pg. 245, (1-25-1993)
Fd. C.I.M. in centerline gravel road with broken top
N 11 degrees E 161.57' N&S in W side 18" Maple
S 16 degrees E 98.66' N&S in W side 8" Maple
S 16 degrees W 135.33' N&S in E side 16" Maple
S 79 degrees W 94.25' N&T in N side T.P.

Liber 4, Page 104, (10-14-1980)
Fd. 5/8" bar from old ties, St C.I.M.
Cen. Tele. Pedestal, WSW 93.54'
Underground Tel. Sign, WNW 63.58'
Cen. St. Sign, E 22.81'
Tw. 7" Oak, SW 58.97'

B. Description of corner evidence found and/or method applied in restoring or reestablishing corner:

M-8
Found 4" Harrison Moument with broken top and accepted as a careful and faithful perpetuation of the position of the original corner.
N 11 degrees E 161.57', 18" Maple (18" Elm)
S 79 degrees W 94.25', T.P.

C. Description of monument for corner and accessories established to perpetuate locating the position of the corner:

M-8 Replaced broken Harrison mon. with 3' long 3/4" iron bar and O.C. Remon. Cap
O.C. Remon. Tag & Nail in NW side P.P., S 35 degrees W 138.07'
O.C. Remon. Tag & Nail in N. side T.P. S. 76 degrees W. 94.48'
O.C. Remon. Tag & Nail in S.W. side 18" Elm N. 8 degrees E. 161.56'
O.C. Remon. Tag & Nail in E. side 5" Hickory N. 9 degrees W. 195.10'
O.C. Remon. Tag & Nail in N. side 5" Elm S. 85 degrees E. 43.24'
(E.D.M.)

Signed by Carl P. Englert Jr. Date December 8, 1993

Surveyor's Michigan License No. 18987

STATE OF MICHIGAN
CARL P. ENGLERT JR.
LAND SURVEYOR
No. 18987
REGISTERED LAND SURVEYOR

FORM APPROVED BY MICHIGAN STATE BOARD OF LAND SURVEYORS, JAN. 28, 1971
REVISED MAY 14, 1975
REVISED JAN., 1983