

1086

OTTAWA COUNTY REMONUMENTATION

RECORDED

COURT REPORT

LAND CORNER RECORDATION CERTIFICATE
Filing Requirement of Act 74, Mich. P.A. 1970

93 DEC 15 AM 9:31

For corners in

<u>Ottawa</u> (County)	Located In:	Corner Code =//
	Crockery Township	
1. Public Land Survey	T <u>8N</u> R <u>R15W</u>	<u>M-11</u>
	T _____ R _____	<u>S.E. Corner</u>
	T _____ R _____	<u>Section 25</u>
	T _____ R _____	_____
2. Property Controlling in Section	S _____ T _____ R _____	_____
	S _____ T _____ R _____	_____
3. Miscellaneous Property in Sec.	S _____ T _____ R _____	_____
	S _____ T _____ R _____	_____

D. J. ...
REGISTER OF DEEDS
OTTAWA COUNTY, MI

Register of Deeds Stamp & File Number

- 4. Lot No. _____, Recorded Plat _____
- 5. Private Claims _____

A	B	C	D	E	F	G	H	I	J	K	L	M
2	6	5	4	3	2	1						
3												
4	7	8	9	10	11	12						
5												
6	18	17	16	15	14	13						
7												
8	19	20	21	22	23	24						
9												
10	30	29	28	27	26	25						
11												
12	31	32	33	34	35	36						
13												

I, Carl P. Englert JR., in a field survey on August 27, 19 93, do hereby certify that under requirements of P.A. 74, Michigan P.A. of 1970, the corner points mentioned in lines 1 and 2 above were in conformance with regulations and rules therefore as required in the current manual of survey instructions of the United States Department of the Interior, Bureau of Land Management or by a decree of a Court of Law and/or that the corner points mentioned in lines 3, 4 and 5 above were in conformance with the rules of the Michigan Board of Land Surveyors or by a Decree of a Court of Law; established, re-established, monumented, re-monumented, recovered, found as expressed below:

NOTE: Not more than 4 corners, all in the same town and range, may be recorded on this certificate.

A. Description of original monument and accessories and/or subsequent restoration:

M-11
L.C.R.C. Liber 3, Page 339, 2/20/79
Fd. 3/8" Rod
N.E. 50.14' 36" Maple
S.E. 48.72' T.P.
S.W. 47.91' 30" Oak
W. 41.10' 24" Maple

L.C.R.C. Liber 4, Page 106, 10/14/80
Fd. 1" Iron pipe from old ties
Set C.I.M.
40" Maple N.E. 50.19'
T.P. S.E. 48.66'
30" Oak S.W. 47.89'
40" Oak W.N.W. 29.86'

B. Description of corner evidence found and/or method applied in restoring or reestablishing corner:


M-11
Found 4" Harrison Cast Iron Monument 8" Deep
and accepted as a careful and faithful perpetuation
of the position of the original corner.
T.P. S.E. 48.66'
36" Oak S.W. 47.89'
40" Maple N.E. 50.19'

C. Description of monument for corner and accessories established to perpetuate locating the position of the corner:

M-11 4" Harrison Cast Iron Monument
O.C. Remon. Tag & Nail in N.W. side 36" Oak S45 degrees W. 47.88'
O.C. Remon. Tag & Nail in S. side 30" Maple West 41.50'
O.C. Remon. Tag & Nail in N.E. side 17" Maple N. 40 degrees W. 44.40'
O.C. Remon. Tag & Nail in N.E. side 40" Maple N. 45 degrees E. 50.50'
O.C. Remon. Tag & Nail in N.E. side T.P. 5.40 degrees E. 48.72'
Tape

Signed by Carl P. Englert Jr.
Surveyor's Michigan License No. 18987

Date December 3, 1993

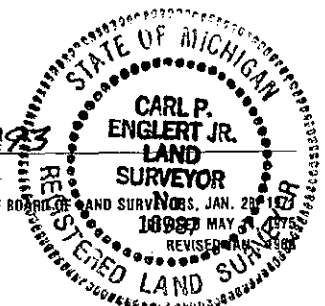

FORM APPROVED BY MICHIGAN STATE BOARD OF LAND SURVEYORS, JAN. 28, 1975, REVISED MAY 1987