FEB 2 4 2000

SECTION

RECORDED

99 SEP 23 PM 3: 20

Gary Deboltz
REGISTER OF DEEDS
OTTAWA COUNTY, MI

Seq. 2

Register of Deeds Stamp & File Number

OTTAWA COUNTY REMONUMENTATION

LAND CORNER RECORDATION CERTIFICATE
Filing Requirement of Act 74, Mich. P.A. 1970

For corners in OTTAWA (County)

	Located In:			Corner Code #
1. Public Land Survey		T 8N	R 15W	M-4 E 1/4 Corner
		T___	R___	Section 12,
		T___	R___	Crockery Twp
		T___	R___	
2. Property Controlling	S___	T___	R___	
in Section	S___	T___	R___	
3. Miscellaneous	S___	T___	R___	
Property in Sec.	S___	T___	R___	

4. Lot No. _____, Recorded Plat _____
5. Private Claims _____

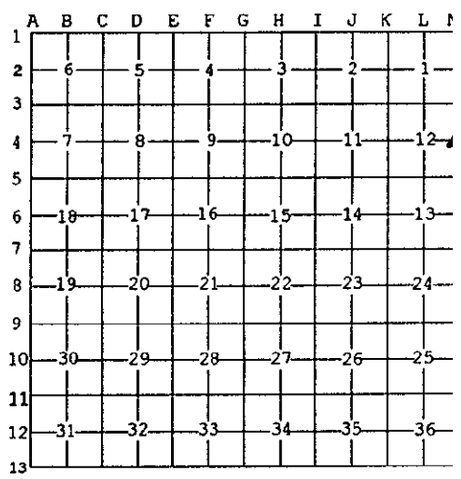

I, Randal J Vugteveen, in a field survey on September 15, 19 99 do hereby state that under requirements of P.A. 74, Michigan P.A. of 1970, the corner points mentioned in lines 1 and 2 above were in conformance with regulations and rules therefore as required in the current manual of survey instructions of the United States Department of the Interior, Bureau of Land Management or by a decree of a Court of Law and /or that the corner points mentioned in lines 3, 4 and 5 above were in conformance with the rules of the Michigan Board of Land Surveyors or by a Decree of a Court of Law; established, re-established, monumented, recovered, found as expressed below:

NOTE: Not more than 2 corners, all in the same town and range, may be recorded on this certificate.

A. Description of original monument and accessories and/or subsequent restoration:

Ottawa County Peer Approved Corner Liber 2, Page 450 (Englert 1995) {4" CIM}
M-4 1/4 corner common to Section 12, T8N, R15W & Section 7, T8N, R14W.
Nail & Remon Tag W side 6" Maple S15°E 135.67'
Nail & Remon Tag SE side 6" Elm S41°W 41.45'
Nail & Remon Tag N side 18" Twin Basswood N64°W 37.69'
Nail & Remon Tag E side 24" Maple N24°W 66.18'
Nail & Remon Tag W side 6" Ash N16°E 83.34'

B. Description of corner evidence found and/or method applied in restoring or reestablishing corner:

M-4 Found cast iron monument 10" below surface, checked the above witness.
Okay on June 3, 1999.
Nail & Remon Tag SE side 6" Elm S41°W 41.45'
Nail & Remon Tag E side 24" Maple N24°W 66.18'
Nail & Remon Tag W side 6" Ash N16°E 83.34'
OCRC to rebuild road at this time.

Accepted Cast Iron Monument as a careful and faithful perpetuation of the position of the original corner.
Set witness irons outside of construction area.

September 15, 1999 recovered witness irons
Set 3/4 " x 24" iron bar by holding witness angles and distances.

C. Description of monument for corner and accessories established to perpetuate locating the position of the corner:

M-4 3/4" x 24" solid bar with Remon Cap

Set Nail & Remon Tag in SW side 12" Ash N64°W 57.01'
Set Nail & Remon Tag in SE side 12" Maple S42°W 103.25'
Set Nail & Remon Tag in E Side 7" Maple S16°E 147.69'
Set Nail & Remon Tag S side 16" Willow N79°E 49.26'
On Centerline gravel road (soon to be paved)
Center of 60" CMP South 82.5' +/-

9/20/99

Receipt #58324

Signed by _____ Date Sept 20 No. 1999

Surveyor's Michigan License No. 28429

RANDAL J. VUGTEVEEN 28429

Receipt #

FORM APPROVED BY MICHIGAN STATE BOARD OF PROFESSIONAL SURVEYORS, JAN. 28, 197
REVISED MAY 14, 19
REVISED JAN. 2, 19
REVISED OCT. 1, 19