

SURVEY & REMONUMENTATION

JUN 28 1999

**OTTAWA COUNTY REMONUMENTATION
LAND CORNER RECORDATION CERTIFICATE
Filing Requirement of Act 74, Mich. P.A. 1970**

RECORDED

98 NOV -4 PM 2:30

SECTION

For corners in


<u>Ottawa</u> (County)	Located In:	Corner Code
1. Public Land Survey	T <u>8N</u> R <u>16W</u>	<u>B5</u>
	T _____ R _____	<u>S 1/4 of 7</u>
	T _____ R _____	<u>SPRING LAKE TWP</u>
	T _____ R _____	_____
2. Property Controlling in Section	S _____ T _____ R _____	_____
	S _____ T _____ R _____	_____
3. Miscellaneous Property in Sec.	S _____ T _____ R _____	_____
	S _____ T _____ R _____	_____

Harry Schell
REGISTER OF DEEDS
OTTAWA COUNTY, MI

Register of Deeds Stamp & File Number

4. Lot No. _____, Recorded Plat _____
5. Private Claims _____

I, Robert E. Lemke in a field survey on April 14, 1998 do hereby state that under requirements of P.A. 74, Michigan P.A. of 1970, the corner points mentioned in lines 1 and 2 above were in conformance with regulations and rules therefore as required in the current manual of survey instructions of the United States Department of the Interior, Bureau of Land Management or by a decree of a Court of Law and /or that the corner points mentioned in lines 3, 4 and 5 above were in conformance with the rules of the Michigan Board of Land Surveyors or by a Decree of a Court of Law, established, re-established, monumented, recovered, found as expressed below:

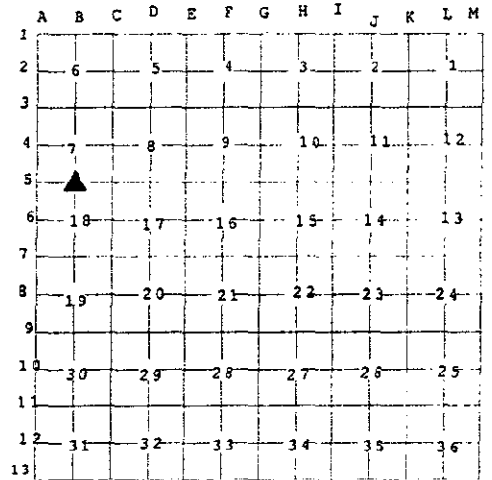

NOTE: Not more than 2 corners, all in the same town and range, may be recorded on this certificate.


A. Description of original monument and accessories and/or subsequent restoration:

B-5 GLO May 1832 West between sec 7 & 18 40.0 Ch Set quarter section post Beech 8" N 85° E 33 lk Beech 7" S 17° W 15 lk	B-5 LCRC (liber 6, page 141) Joiner 1991 Set on line between SE corner of the SE corner of N. Shore Estates Subdivision #2 at proportioned measurement
---	---

Liber 6 Page 141 (Cont)
Set Cast Iron Monument
NNW 41.00' P.P.
SSW 23.38' Tallest post in Sign
SE 68.75' 16" Beech
NE 48.18' CL Hydrant

B. Description of corner evidence found and/or method applied in restoring or reestablishing corner:

B-5
Found Cast Iron Monument
P.P. NW 41.00' (m=41.02') to Nail & tag
Tallest post in sign SSW 23.38' (m=23.43) to Nail
16" Beech SE 68.74' to Nail & tag
CL Hydrant NE 48.18' (m=48.25')
And is accepted as a careful and faithful perpetuation of the position of the original corner

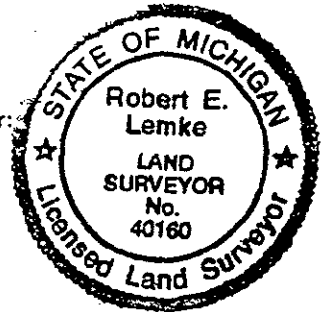

C. Description of monument for corner and accessories established to perpetuate locating the position of the corner:

B-5
Cast Iron Monument
Set O.C. Remon. Nail & tag E side P.P. N 30° W 41.02'
Set O.C. Remon. Nail & tag SW side tallest Sign post S 15° E 23.69'
Set O.C. Remon. Nail & tag S side 16" Beech S 75° E 68.78'
Centerline Hyd. N 30° E 48.25'

NEED APPROVED 10/19/98
907
\$9.00 CORNER
Receipt # 220
\$1.00 FRO
Receipt # 220
APPROVED REMONUMENTATION CORNER
P.A. 345 OF 1990
OTTAWA COUNTY

DATE APPROVED _____

COUNTY REP. _____

Signed by *Robert E. Lemke*

Date 4/14/98

SDI Consultants, Ltd.
Surveyor's Michigan License No. 40160