

SURVEY & REMONUMENTATION

APR 25 1995

COMMISSION

OTTAWA COUNTY REMONUMENTATION

LAND CORNER RECORDATION CERTIFICATE

Filing Requirement of Act 74, Mich. P.A. 1970

RECORDED

DEC -8 PM 12:28

For corners in OTTAWA

Phyllis Ballman
REGISTER OF DEEDS
OTTAWA COUNTY, MI

(County)	Located In:	Corner Code #
1. Public Land Survey	T 8N R 16W	C-2, W 1/2 Corner
	T R	Section 5
	T R	Spring Lake Twp.
	T R	
2. Property Controlling in Section	S T R	
	S T R	
3. Miscellaneous Property in Sec.	S T R	
	S T R	
4. Lot No. _____, Recorded Plat _____		
5. Private Claims _____		

Register of Deeds Stamp & File Number

I, THOMAS E. JOINER in a field survey on 10-13- 19 94 do hereby certify that under requirements of P.A. 74, Michigan P.A. of 1970, the corner points mentioned in lines 1 and 2 above were in conformance with regulations and rules therefore as required in the current manual of survey instructions of the United States Department of the Interior, Bureau of Land Management or by a decree of a Court of Law and/or that the corner points mentioned in lines 3, 4 and 5 above were in conformance with the rules of the Michigan Board of Land Surveyors or by a Decree of a Court of Law; established, re-established, monumented, re-monumented, recovered, found as expressed below:

A	B	C	D	E	F	G	H	I	J	K	L	M
2	6	5	4	3	2	1						
3												
4	7	8	9	10	11	12						
5												
6	18	17	16	15	14	13						
7												
8	19	20	21	22	23	24						
9												
10	30	29	28	27	26	25						
11												
12	31	32	33	34	35	36						
13												

NOTE: Not more than 4 corners, all in the same town and range, may be recorded on this certificate.


A. Description of original monument and accessories and/or subsequent restoration:

04-03-1837	Liber 4, Pg. 190, 05-27-81	Liber 3, Pg. 277, 08-18-78
Post set by John Mullet, D.S.	Set Cast Iron Monument	Found Concrete monument
S86°W 22 18" Hemlock	N86°W 42.81 12" Triple Maple	N86°W 42.88 12" Triple Maple
N64°E 12 4" Hemlock	E. 137.25 Angle iron in road	S40°W 48.62 NE Cor. Sign Planter
	NE 30.42 7" Cherry	N85°E 30.45 8" Cherry
	E. 75.37 28" Maple	E. 137.25 Angle iron in road

B. Description of corner evidence found and/or method applied in restoring or reestablishing corner:

Found Cast Iron Monument and accepted as a careful and faithful perpetuation of the position of the original corner.

Liber 4, Pg. 190, 05-27-81	Liber 3, Pg. 277, 08-18-78
N 86° W 42.81 12" Triple Maple	N 86° W 42.88 12" Triple Maple
East 137.25 Angle Iron in Road (under asphalt)	East 137.25 Angle Iron in Road (under aspha

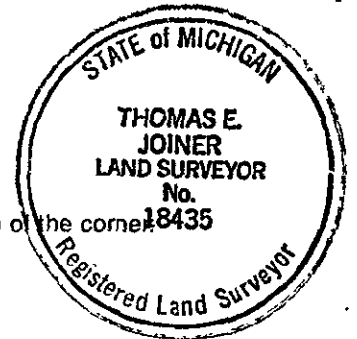

C. Description of monument for corner and accessories established to perpetuate locating the position of the corner:

Cast Iron Monument

O.C. Remon Tag & Nail in NW side 16" Maple	Az. 38°	59.25
O.C. Remon Tag & Nail in S side 15" Oak	Az. 81°	40.12
O.C. Remon Tag & Nail in N side Triple 16" Maple	Az. 275°	42.79
O.C. Remon Tag & Nail in W side 11" Beech	Az. 310°	44.16
F.I.P. in asphalt	Az. 90°	144.53

PA. 345 OTTAWA COUNTY

PEER APPROVED

11/21/94

Signed by Thomas E. Joiner

Date 11-21-94

Surveyor's Michigan License No. 18435