

# SURVEY & REMONUMENTATION

APR 25 1995

## COMMISSION

### OTTAWA COUNTY REMONUMENTATION LAND CORNER RECORDATION CERTIFICATE Filing Requirement of Act 74, Mich. P.A. 1970

RECORDED

94 DEC -8 PM 12: 28

*D. J. ...*  
REGISTER OF DEEDS  
OTTAWA COUNTY, MI

For corners in

OTTAWA (County)	Located In:	Corner Code #
1. Public Land Survey	T <u>8N</u> R <u>16W</u>	C-3, SW Corner Section 5 Spring Lake Twp
	T _____ R _____	_____
	T _____ R _____	_____
	T _____ R _____	_____
2. Property Controlling in Section	S _____ T _____ R _____	_____
	S _____ T _____ R _____	_____
3. Miscellaneous Property in Sec.	S _____ T _____ R _____	_____
	S _____ T _____ R _____	_____
4. Lot No. _____, Recorded Plat _____		
5. Private Claims _____		

Register of Deeds Stamp & File Number

	A	B	C	D	E	F	G	H	I	J	K	L	M
2	6	5	4	3	2	1							
3		●											
4	7	8	9	10	11	12							
5													
6	18	17	16	15	14	13							
7													
8	19	20	21	22	23	24							
9													
10	30	29	28	27	26	25							
11													
12	31	32	33	34	35	36							
13													

I, THOMAS E. JOINER, in a field survey on 10-13- 19 94, do hereby certify that under requirements of P.A. 74, Michigan P.A. of 1970, the corner points mentioned in lines 1 and 2 above were in conformance with regulations and rules therefore as required in the current manual of survey instructions of the United States Department of the Interior, Bureau of Land Management or by a decree of a Court of Law and/or that the corner points mentioned in lines 3, 4 and 5 above were in conformance with the rules of the Michigan Board of Land Surveyors or by a Decree of a Court of Law; established, re-established, monumented, re-monumented, recovered, found as expressed below:

**NOTE: Not more than 4 corners, all in the same town and range, may be recorded on this certificate.**


A. Description of original monument and accessories and/or subsequent restoration:

04-02-1837	Liber 3, Pg. 377, 08-27-79	Liber 2, Pg. 747, 02-20-75
Post set by John Mullet, D.S.	Set Cast Iron Monument	Set 5/8" Rod
S 49° E 21 10" Beech	NE 14.59 6" Red Oak	N 55.40 14" Beech
N 27° W 23 9" Beech	NE 55.13 20" White Oak	NW 48.38 30" Beech
	NW 55.40 14" Beech	NW 97.50 16" Beech
	NW 48.38 30" Beech	NE 14.79 6" Oak

3. Description of corner evidence found and/or method applied in restoring or reestablishing corner:

Found Cast Iron Monument and accepted as a careful and faithful perpetuation of the position of the original corner.

Liber 3, Pg. 377, 08-27-79	Liber 2, Pg. 747, 02-20-75
NE 14.59 6" Red Oak	North 55.40 14" Beech
NE 55.13 20" White Oak	NW 48.38 30" Beech
NW 55.40 14" Beech	NE 14.79 6" Oak
NW 48.38 30" Beech	

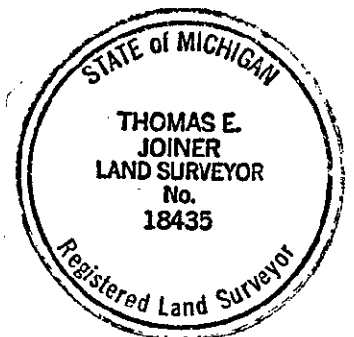

C. Description of monument for corner and accessories established to perpetuate locating the position of the corner:

Cast Iron Monument

O.C. Remon Tag & Nail in W side 12" Red Oak	Az. 25°	15.02
O.C. Remon Tag & Nail in E side Twin " Red Oak	Az. 137°	36.61
O.C. Remon Tag & Nail in SW side 34" Beech	Az. 349°	49.84
O.C. Remon Tag & Nail in E side 14" Beech	Az. 05°	55.87

PA. 345 OTTAWA COUNTY  
PEER APPROVED 11/21/94

Signed by Thomas E. Joiner Date 11-21-94  
Surveyor's Michigan License No. 18435