

**SURVEY & REMONUMENTATION**

JUN 28 1999

**OTTAWA COUNTY REMONUMENTATION  
LAND CORNER RECORDATION CERTIFICATE  
Filing Requirement of Act 74, Mich. P.A. 1970**

RECORDED

98 NOV -4 PM 2: 30

For corners in

**SECTION**

<u>Ottawa</u> (County)	Located In:	Corner Code
1. Public Land Survey	T <u>8N</u> R <u>16W</u>	<u>C-4</u>
	T _____ R _____	<u>(E 1/4 7)</u>
	T _____ R _____	<u>SPRING LAKE TWP</u>
	T _____ R _____	_____
2. Property Controlling in Section	S _____ T _____ R _____	_____
	S _____ T _____ R _____	_____
3. Miscellaneous Property in Sec.	S _____ T _____ R _____	_____
	S _____ T _____ R _____	_____


*Ray Schultz*

REGISTER OF DEEDS  
OTTAWA COUNTY, MI

Register of Deeds Stamp & File Number

4. Lot No. \_\_\_\_\_, Recorded Plat \_\_\_\_\_  
5. Private Claims \_\_\_\_\_

I, Robert E. Lemke, in a field survey on April 14, 1998 do hereby state that under requirements of P.A. 74, Michigan P.A. of 1970, the corner points mentioned in lines 1 and 2 above were in conformance with regulations and rules therefore as required in the current manual of survey instructions of the United States Department of the Interior, Bureau of Land Management or by a decree of a Court of Law and /or that the corner points mentioned in lines 3, 4 and 5 above were in conformance with the rules of the Michigan Board of Land Surveyors or by a Decree of a Court of Law; established, re-established, monumented, recovered, found as expressed below:

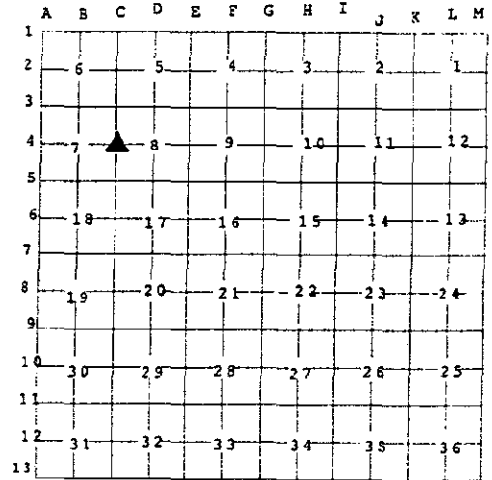

NOTE: Not more than 2 corners, all in the same town and range, may be recorded on this certificate.

A. Description of original monument and accessories and/or subsequent restoration:  
(see back of page)

B. Description of corner evidence found and/or method applied in restoring or reestablishing corner:



C-4  
found cast iron monument in ground and old concrete monument laying on ground witness's per LCRC (liber 6, page 141)  
4" Oak SSE 56.12' to Nail (m=56.15')  
10" Tw Oak W 48.85' to Nail (m=48.82')  
witness's per LCRC (liber 2, page 747)  
18" Oak N 12 E 158.04' (m=157.95) to Nail  
30" Beech S 45 W 80.30' (m=80.90) to Nail  
And is accepted as a careful and faithful perpetuation of the position of the original corner.

C. Description of monument for corner and accessories established to perpetuate locating the position of the corner:

C-4	Cast iron Monument				
O.C. Remon. Nail & tag	E. Side	4" Oak	S 18° E	56.15'	
O.C. Remon. Nail & tag	S. side	10" Tw. Oak	N 90°W	49.00'	
O.C. Remon. Nail & tag	W. side	18" Oak	N 12° E	157.95'	
O.C. Remon. Nail & tag	W. side	30" Beech	S 45° W	80.90'	

10/19/98  
*MDJ*

APPROVED REMONUMENTATION CORNER  
P.A.345 OF 1990  
OTTAWA COUNTY

DATE APPROVED \_\_\_\_\_

COUNTY REP. \_\_\_\_\_

Signed by Robert E. Lemke

Date 4/14/98

SDI Consultants, Ltd.

Surveyor's Michigan License No. 40160

\$11.00 CORNER  
 Receipt #18213  
 \$2.00 PHOTO  
 Receipt #18213

A. Description of original monument and accessories and/or subsequent restoration: C-4 continued

GLO

May 1832

North between sections 7 & 8

40.0 Ch Set quarter post

Hemlock 7" S 30° W 08 lks

Hemlock 12" N 1° W 12 lks

C-4

C.P. Englert Jr.

February 20, 1975

(liber 2, page 747)

(Found) Conc. Mon.

N.W. 18" Oak 158.04'

S.W. 10" Beech 80.30'

S.W. 6" Oak 71.40'

S.W. 8" Oak 67.81'

C-4 LCRC

T. Joiner

May 07, 1991

(Liber 6, Page 141)

Fd. Concrete Monument

SSE 56.12' 4" Oak

SW 71.54' 10" Oak

W 48.85' 8" Tw. Oak

N 100.00' Iron Bar

SURVEY &  
REMONUMENTATION

JUN 28 1999

SECTION